

GOVERNMENT CORNER RESTORATION FORM

FILED

Date: 10/24/05 By: JC

Township 22 S Range 8 W Sec. 29 County DOUGLAS

This survey consists of:

State OR Date 9-26-05 No. 240221

Map: \_\_\_\_\_

Name: \_\_\_\_\_

Corner rpt: 67/13-12

Corner Designation

CLOSING CORNER AT INTERSECTION  
OF SOUTH BOUNDARY D L C 45

DOUGLAS COUNTY

Condition: Surveyed

Not Found

Renewed

Unrecorded

Surveyed In


Referenced Out

MONUMENT DETAIL

Previous Renewals EST. BY BLM IN 1965

Monument(s) Found: (Condition and Source)

3" BRASS CAP ON 2 1/2" IRON POST  
PROJECTS 8" ABOVE GROUND.

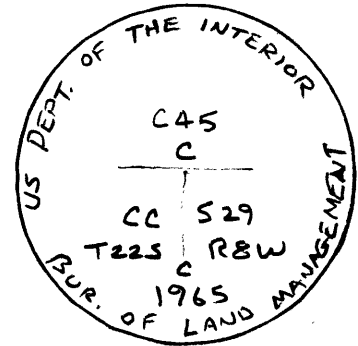

Accessories Found:

ORIG. 9" Now 21" D. FIR, FULLY HEALED SINGLE BLAZE VISIBLE  
BEARS S 26° W, 48 3/4 FT. (AGREES W/REC.) 1965 BT,

ORIG. 6" Now 13" D FIR, FULLY HEALED SINGLE BLAZE VISIBLE  
BEAR S 56° E, 73 6 FT. (AGREES WITH RECORD) 1965 BT

C.S. File No 67/13-12

