

GOVERNMENT CORNER RESTORATION FORM

FILED

Date: 12/14/2005 By: JC

This survey consists of:

Township 22S Range 5W Sec. 32 County DOUGLAS

State OREGON Date DEC. 1, 2005 No. 300140

Corner Rpt: 67/13-16

Corner Designation

$\frac{1}{4}$
S 32 | S 33

DOUGLAS COUNTY
SURVEYOR

Condition Report Only

Not Found

Renewed

Unrecorded

Surveyed In


Referenced Out

MONUMENT DETAIL

Previous Renewals THIEL 1960; HAINES 1967; DCSO 1975

Monument(s) Found: (Condition and Source)

3" ALUM CAP ON ALUM POST
MARKED AS SHOWN. FIRMLY SET.
AC/AP PROJECTS 8" ABOVE
GROUND. 5/8" IRON ROD ALONGSIDE.

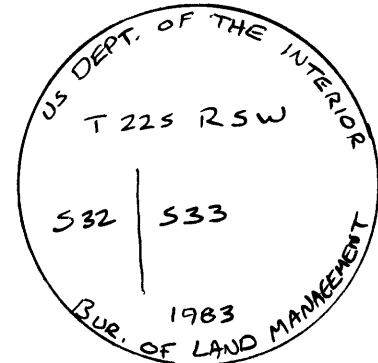

Accessories Found:

29" FIR NOW 29" X 5 FT. TALL STUMP. BEARS

