

GOVERNMENT CORNER RESTORATION FORM

Date: 12-14-2005 By: JC

Township 22S Range 5W Sec. 28

County Douglas

This survey consists of:

State OREGON

Date DEC. 6, 2005

No. 340208

Corner Rpt: 67/13-17

Corner Designation

1/4
S 28
S 33


DOUGLAS COUNTY SURVEYOR

- Condition Report Only
- Not Found
- Renewed
- Unrecorded
- Surveyed In
- Referenced Out

Previous Renewals Bloom 1980; BLM 1982

Monument(s) Found: (Condition and Source)

3" ALUM. CAP ON ALUM POST
 FLUSH WITH GROUND, LIES
 1 FT. SOUTH OF NEWER E-W
 WIRE FENCE NEXT TO WOODEN
 FENCE POST. 5/8" I.R. IS
 FOUND ON WEST SIDE OF AC/AP

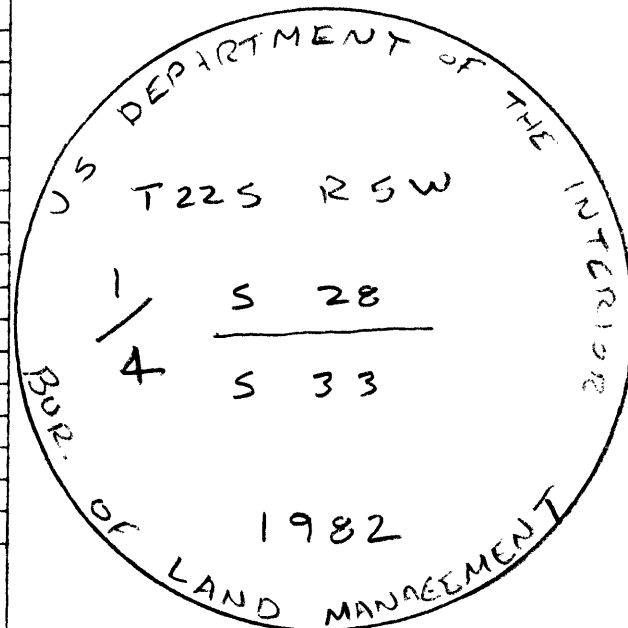

Accessories Found:

12" FIR NOW 18" DIA. X 7 FT. TALL TIPPED OUT STUMP
 FULLY HEALED BLAZE & TAG VISIBLE ROOT HOLE NEAR
 REC. BRG & DIST. (REC. N 29° E, 37 1/4 FT. BLM) 1980 BT

10" FIR NOW 14" DIA. D. FIR TIPPED OVER OUT OF POSITION
 DOUBLE BLAZE & TAG VISIBLE ROOT HOLE NEAR REC. BRG & DIST.
 (REC. S 33° E, 42 3/4 FT. BLM) 1980 BT

