

GOVERNMENT CORNER RESTORATION FORM

FILED

Date: 12-30-2005 By: JC

Township 22S Range 5W Sec. 32

County DOUGLAS

This survey consists of Map

State OR Date 12-14-05

No. 300100

Narrative: \_\_\_\_\_  
Corner Rpt: 67/13-18

Corner Designation

SE COR SEC. 32

DOUGLAS COUNTY  
SURVEYOR

Condition of Monument Only

Not Found

Renewed

Unrecorded

Surveyed In

Referenced Out


MONUMENT DETAIL

Previous Renewals DCSO 1965 & 1975; BLM 1983

Monument(s) Found: (Condition and Source)

3" DIA ALUM. CAP (MARKED AS SHOWN)  
ON 2 1/2" ALUM. POST, FLUSH WITH  
GROUND.

2 1/4" DIA. BRASS CAP DATED 1965  
FLUSH W/GROUND LEANS  
TO WEST. THIS BC/IP BEARS  
SOUTH 4 3/4 FT. FROM BLM AC/AP.

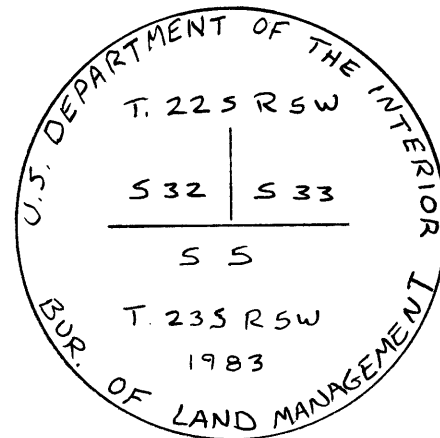

Accessories Found:

FROM 1983 BLM AC/AP

10" GRAND FIR NOW 18" DIA. X 4 FT. TALL SHATTERED STUMP  
HEALED SINGLE BLAZE & TAG VISIBLE. BEARS N 18 1/2° E, 37 1/4 FT.  
(REC. N 18 1/2° E, 28 7/8 FT.) 1983 BLM TREE

8" FIR NOW 12" DIA. X 4 FT. TALL ROTTING STUMP. FULLY HEALED  
BLAZE & TAG VISIBLE. BEARS N 33° W, 89 1/2 FT.  
(AGREES W/REC.) 1983 BLM TREE

FROM 1965 DCSO BC/IP

8" MAPLE NOW 11" DIA. STUMP WITH MULTIPLE RESPROUTED  
STEMS ABOVE BLAZE HEIGHT W/PARTIAL SCRIBING VISIBLE.  
BEARS N 64° W, 36 1/2 FT. TO DCSO CAP (AGREES W/REC)  
D.C.S.O. TREE, 1975

AN ORIGINAL 12" FIR NOW 51" DIA. X 6 FT. TALL GRAND FIR  
STUMP HAS BEEN OPENED & ONLY PARTLY HEALED BACK.  
BEARS N 23° E, 79 FT TO DCSO CAP (AGREES W/REC)  
ORIG. BT, 1855

C.S. File No 67/13-18

