

GOVERNMENT CORNER RESTORATION FORM

3

Township 27S Range 5W Sec. _____ County DOUGLAS

State OREGON Date JAN 4, 2006 No. 300100

Corner Designation

STANDARD CORNER FOR SECTIONS
4 & 5 ONLY T. 23S R. 5W ON
NORTH LINE

Previous Renewals HAINES 1959; DESO 1959, 1976 BLM 1982

Monument(s) Found: (Condition and Source)

3" DIA ALUM MARKED AS SHOWN
5" BELOW SURFACE ON WEST SIDE
OF LOGGING ROAD.

Accessories Found:

36" FIR STUMP NOW INDETERMINATE DIA. 3 FT. TALL ROTTING
STUMP. PREVIOUSLY OPENED FACE WITH FAINT MARKINGS VISIBLE
BEARS S 58° E, 33 FT. (AGREES W/REC.) ORIG. BT

16" R. FIR NOW 18" DIA. X 3 1/2 FT. TALL STUMP FULLY HEALED BLAZE
VISIBLE, BEARS S 46 1/2° E, 68 FT. (REC. S 45° E, 89 FT.) 1959 BT

11" R. FIR, NOW 15" DIA X 1 1/2' TALL STUMP FULLY HEALED BLAZE
VISIBLE, BEARS S 16 1/2° W, 14 FT. (REC. S 19° W, 14 FT.) 1959 BT

FILED
Date: 1-24-2006 By JC


This survey consists of:
Map: _____

Narrative: _____

Corner Rpt: 67/14-1

DOUGLAS COUNTY
SURVEYOR
Condition of Record Only
 Not Found
 Renewed
 Unrecorded
 Surveyed In
 Referenced Out

MONUMENT DETAIL

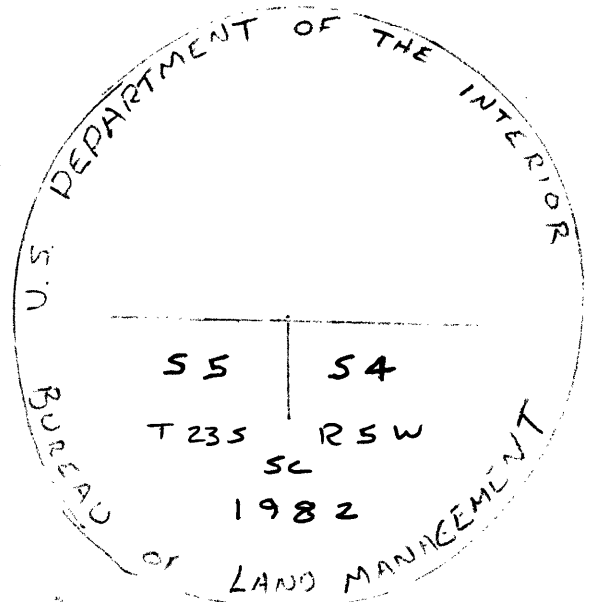

C.S. File No 67/14-1

