

GOVERNMENT CORNER RESTORATION FORM

FILED

Date: 2-16-2006 By: DC

Township 23 S Range 5 W Sec. 6

County DOUGLAS This survey consists of:

State OR Date 1-25-2006

No. 140 600 Map: CS 67/14-3

Corner Designation

$\frac{1}{4}$ $\frac{S 6}{S 7}$

Corner Rpt: _____

DOUGLAS COUNTY

Condition: RENEWED Only

Not Found

Renewed

Unrecorded

Surveyed In


Referenced Out

MONUMENT DETAIL

Previous Renewals THEIL, 1951; HAYDEN, 1952; DCSO, 1960;

Monument(s) Found: DCSO, 1978 (Condition and Source)

2 1/2" B.C. ON 1 1/4" D.I.A. IRON
PIPE FIRMLY SET PROJECTING
12" ABOVE GROUND WITH
FLANGED AXLE FLUSH W/GROUND
ON EAST EDGE.

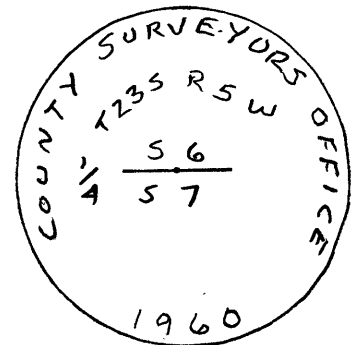

Accessories Found:

ORIG. 44" DIA. FIR NOW 60" DIA. X 5 FT. TALL ROTTING
STUMP SCRIBE MARKS "1/4 S BT" VISIBLE ON OPENED
EXPOSED BLAZE, BEARS S 50°W, 16 1/2 FT. (REC. S 54 3/4°W, 13 1/2 FT.)
ORIG. BT

10" NOW 30" DIA. W. FIR, FULLY HEALED DOUBLE BLAZE VISIBLE
BEARS S 45°E, 26.6 FT. (REC. S 45°E, 25 1/2 FT.) 1951 BT

10" NOW 19" DIA. X 4 FT. TALL D. FIR STUMP, FULLY
HEALED DOUBLE BLAZE VISIBLE. BEARS N 17°E 67 1/2 FT.
(AGREES W/DCSO 1978 REC) 1951 BT

NO EVID. FOUND OF 1978 NW BT (REC. N 88°W, 18 1/2 FT.)

