

GOVERNMENT CORNER RESTORATION FORM

FILED

Township 235 Range 7W Sec. 12 County DOUGLAS Date: 2-16-2006 By: X

State OR Date JAN. 30, 2006 No. 640500 This survey consists of: Map: _____

Corner Designation AS 67/14-4 Narrative: _____

$\frac{1}{4}$ S 12
S 13

- DOUGLAS COUNTY Only
- Condition Report
 - Not Found
 - Renewed
 - Unrecorded
 - Surveyed In
 - Referenced Out

Previous Renewals HAINES 1957; DCSO 1962

Monument(s) Found: (Condition and Source)

HAINES T. IRON W/ BRASS WASHER

ATTACHED - LOOSE ON TOP OF GROUND -

NO SIGN OF 1962 D.C.S.O. BC/IP.

MONUMENT DETAIL

Accessories Found:

ORIG 60" FIR NOW ROTTING D. FIR STUMP APPROX. 60" DIA

X 4 FT. TALL POSSIBLE FRAGMENTARY BARK SCRIBING VISIBLE

BELOW TAG, BEARS N 4° E 21 1/2 FT. TO CENTER

OF STUMP. AGREE WITH 19 1/2 FT. TO FACE. (DCSO 1962)

(REC. N 10° E 19 1/2 FT.) ORIG. BT.

ORIG. 60" FIR NOW ROTTING D. FIR STUMP, APPROX 55" DIA.

X 3 FT. TALL. NO SCRIBE OR FACE VISIBLE. BEARS

S 28° W 36 3/4 FT. TO CENTER OF STUMP. AGREE WITH

33 3/4 FT. MEAS. TO FACE. (DCSO 1962) (REC. S 30° W, 33 3/4 FT)

ORIG. BT

18" NOW 31" DIA. HEMLOCK, HEALED BLAZE VISIBLE

BEARS N 16° W, 57 1/2 FT. (AGREES W/REG) 1962 1BT

17" NOW 21" DIA. YEW, HEALED BLAZE VISIBLE


BEARS S 68° E, 30 3/4 FT. (AGREES W/REG) 1962 BT

RENEWAL

Monument Set (Procedure and Description)

Monument Detail

SET NEW BC (2 3/8" DIA ON 1 1/4" O.D. X 32" LONG. I.P.
 AT INTERSECTION OF BEARING AND
 DISTANCES OF THE 1962 RENEWAL
 TREES. FACE MEASUREMENTS TO
 ORIG. BT'S AGREED WELL WITH
 OUR PLACEMENT. RESET HAINES
 T-IRON FLUSH WITH GROUND ON
 SOUTH EDGE OF BC/IP. NEW BC
 PROJECTS 3" ABOVE GROUND

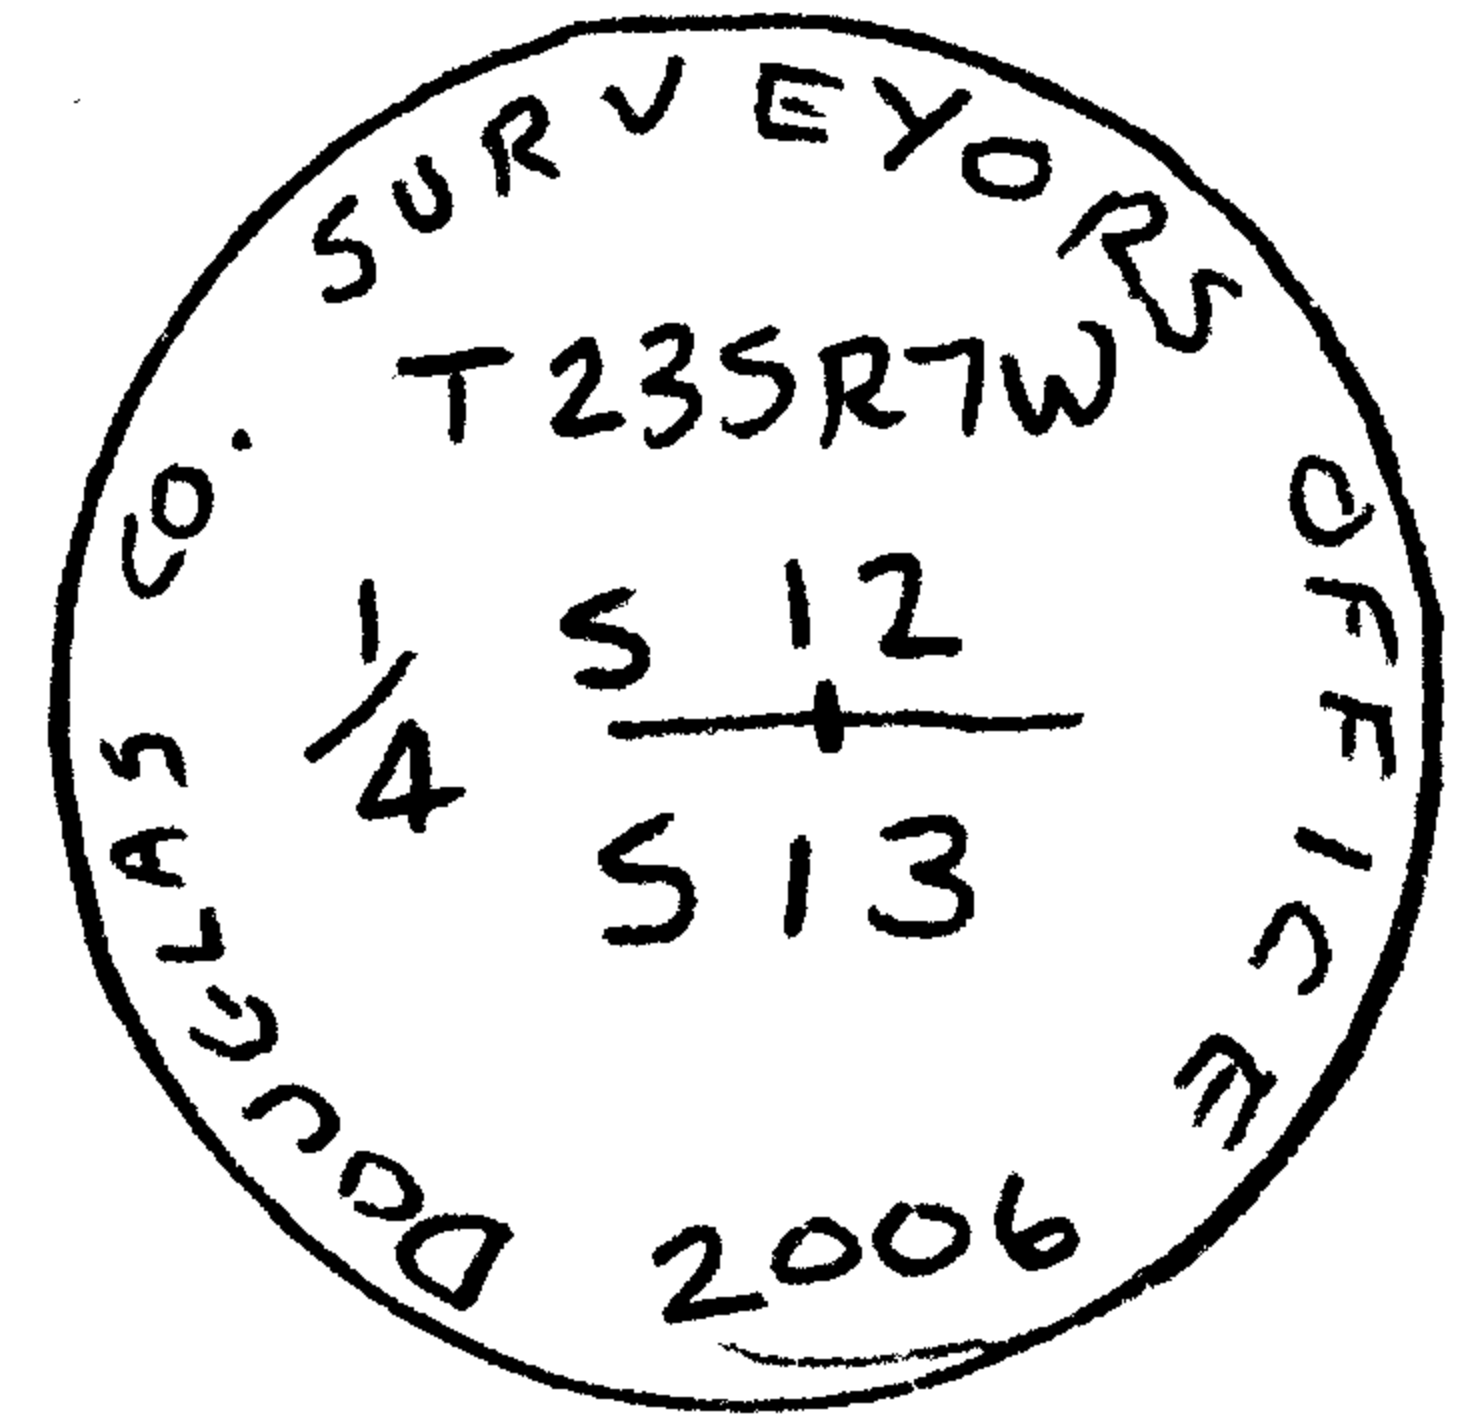


New Accessories

22" DIA. W. FIR, DOUBLE BLAZED & SCRIBED "1/4 S 13 CS BT"
 BEARS S 26° E, 27 1/2 FT.

7" DIA. R. CEDAR, DOUBLE BLAZED & SCRIBED "1/4 S 12 CS BT"
 BEARS N 76 1/2° W, 46 1/2 FT.

Sketch of Monument, Accessories, and General Area

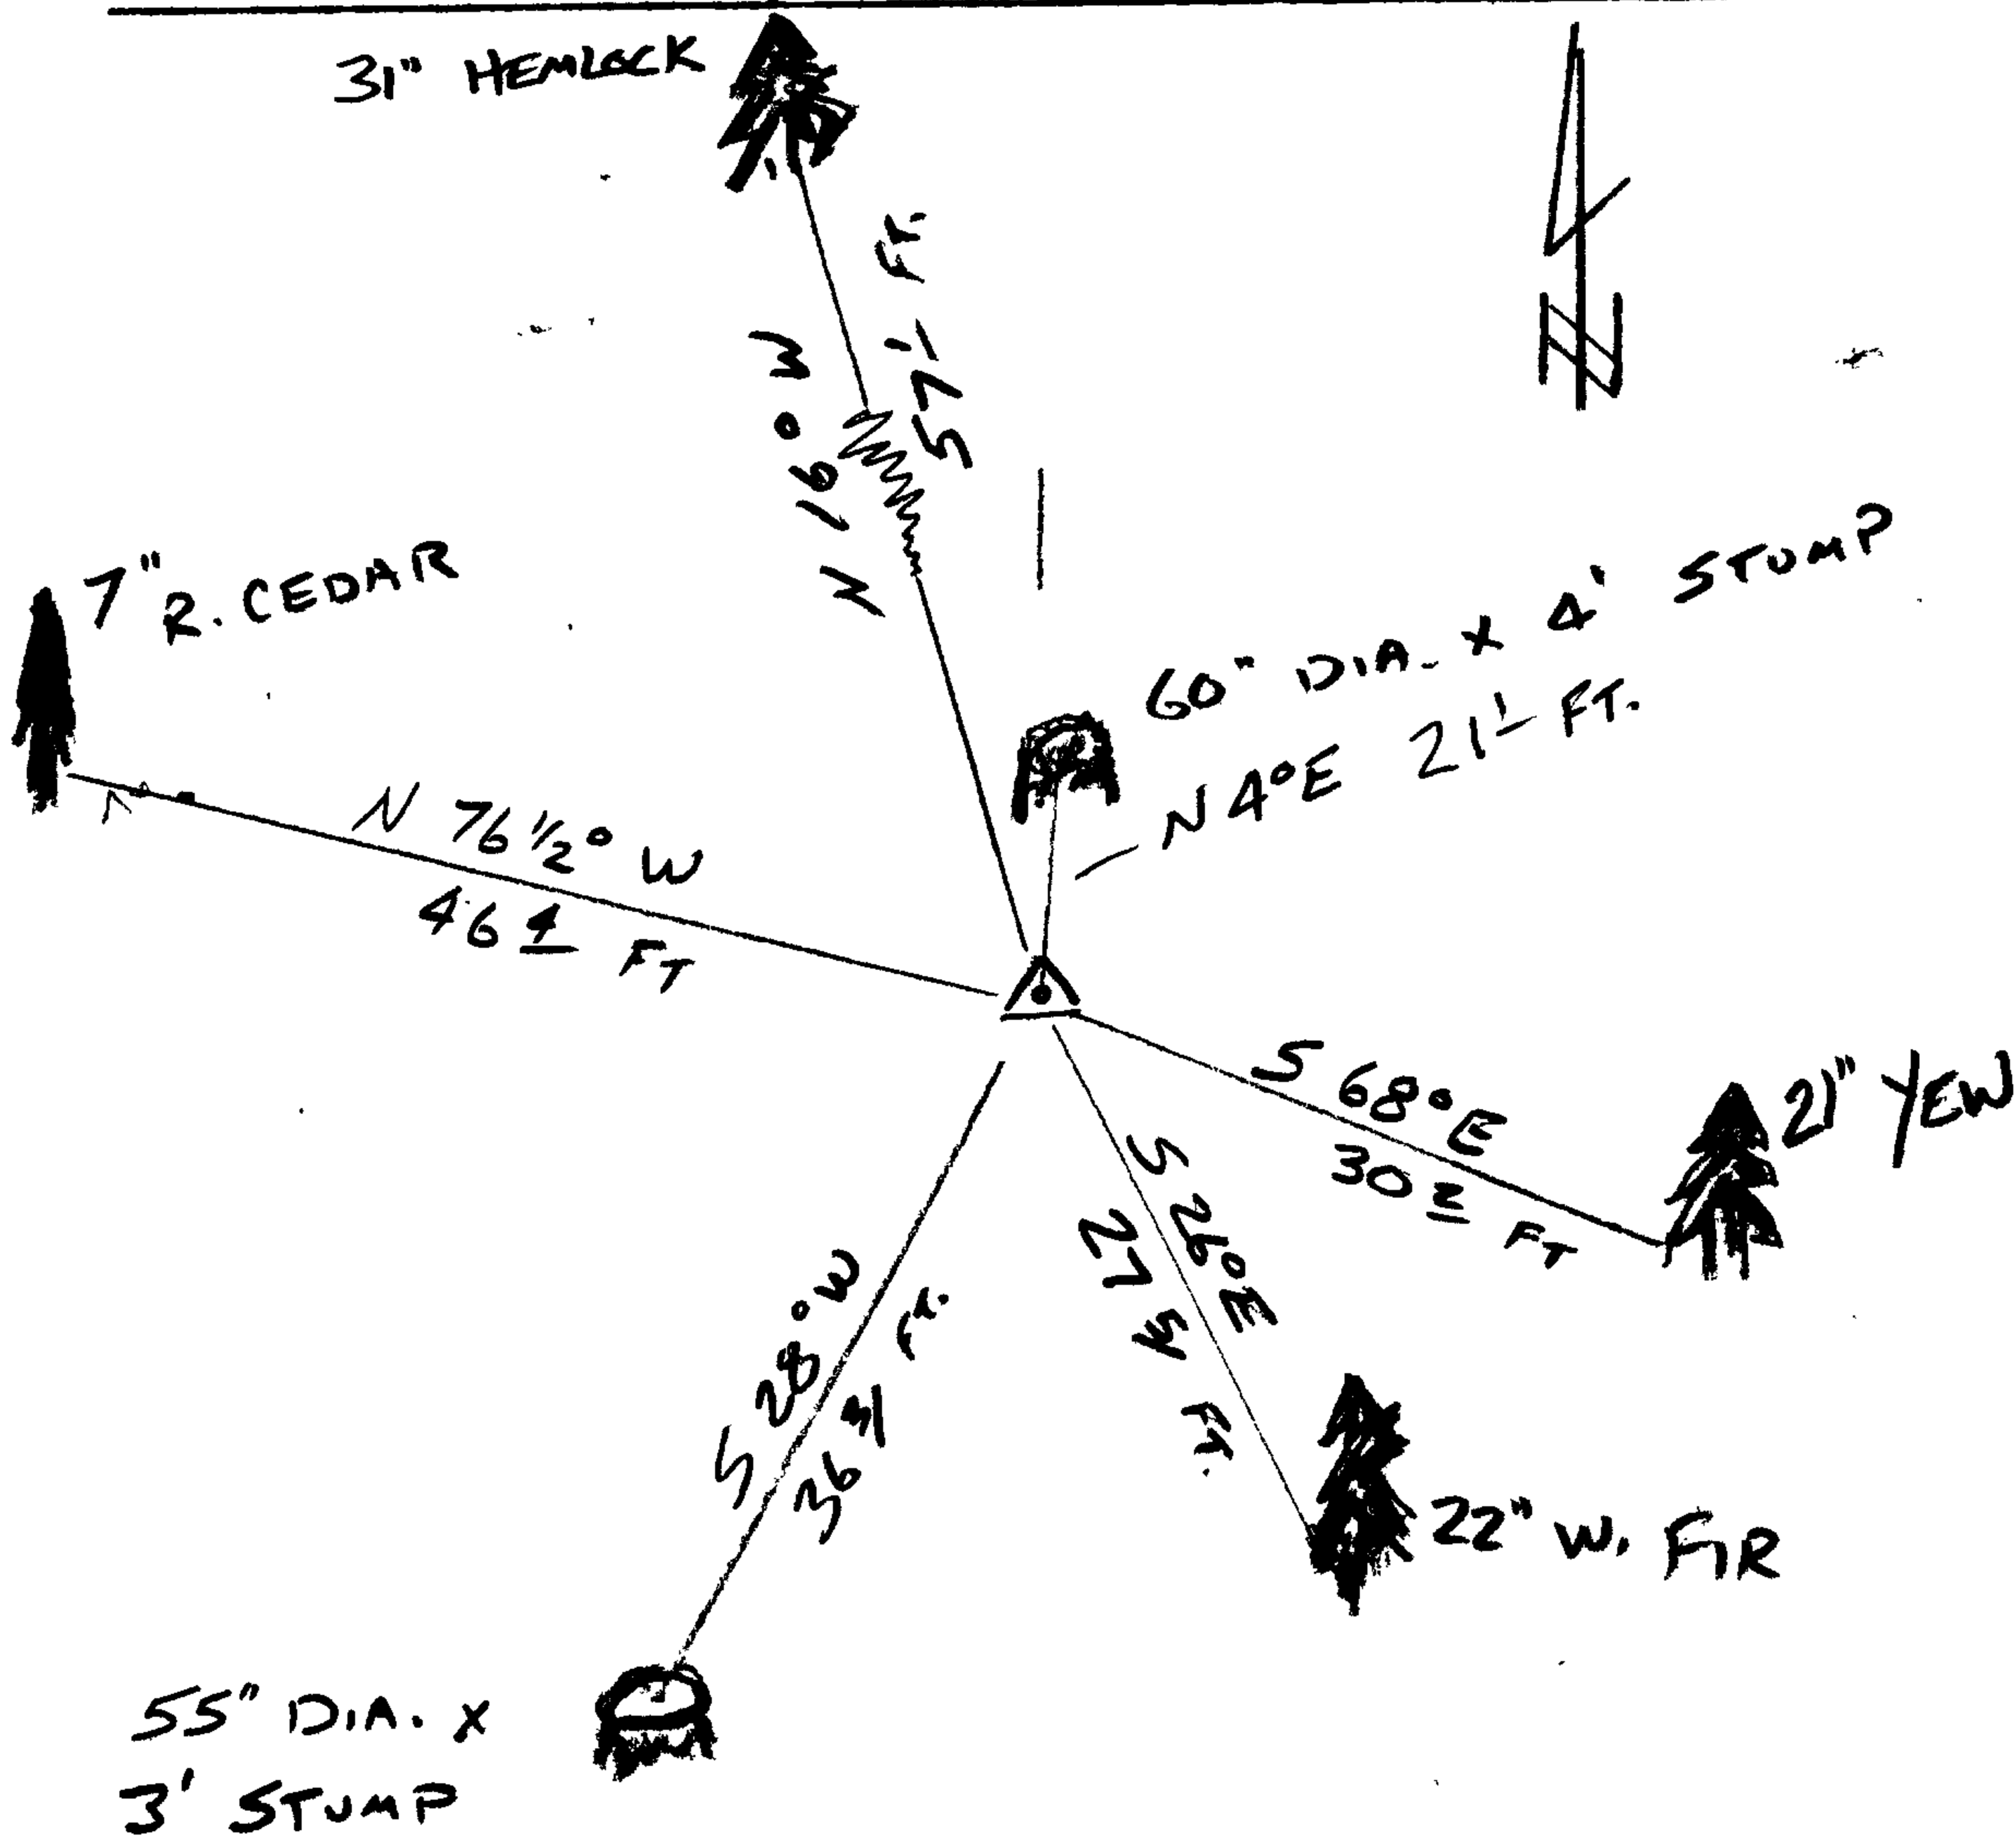

Location & Comments

Comp. Declin. 16 1/2° E
 Agency D.C.S.O.
 Party Chief S. FLAUSE
 Notekeeper J. PIKE
 Witnesses _____

Address

Surveyor's Seal
 REGISTERED
 PROFESSIONAL
 LAND SURVEYOR

Randall W. Smith
 ROWNS 6-30-07

OREGON
 JULY 25, 1990
 RANDALL W. SMITH
 2408