

GOVERNMENT CORNER RESTORATION FORM

Date: 2/21/2006 By: JC

Township 23 S Range 5 W Sec. _____

County DOUGLAS The survey consists of: _____

State OR Date 1-31-2006 No. 038048

Corner No. 67/14-5

Corner Designation

SE CORNER MILLER DLC 38

DOUGLAS COUNTY

Condition Report Only

Not Found

Renewed

Unrecorded

Surveyed In


Referred Out

Previous Renewals W. HAINES, 1973; H. NORTHCRAFT, 1988

Monument(s) Found: (Condition and Source)

STONE LAYING ON GROUND WITH CHISELED FACE POINTING UPWARD MARKED "C 38 23 S 5 W" (ORIG. STONE) AND 5/8" I.R. PROJECTS 4" ABOVE GROUND ON NORTHERLY EDGE OF STONE. (HAINES 1973)

NOTE: WE ACCEPT HAINES 5/8" I.R. (MS2-9) AS BEST POSITION OF CORNER BECAUSE WE FEEL THE STONE WAS PROBABLY SET UPRIGHT AS IN OTHER DLC'S IN AREA AS DID W. HAINES.

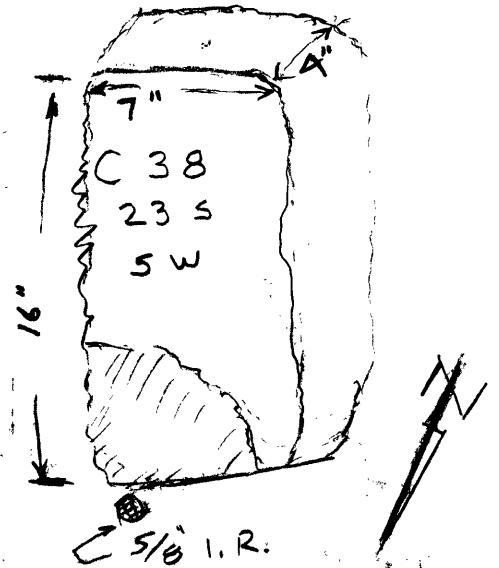

Accessories Found:

NO CLEAR EVIDENCE OF ANY ACCESSORIES FOUND CORNER LIES IN AREA OF FAST GROWING TREES

