

GOVERNMENT CORNER RESTORATION FORM

FILED

Township 235 Range 5W Sec. 4 County Douglas Date: 4-18-2006 By: JC  
This survey consists of:  
State OR Date 4-12-2006 No. 30060 Map: \_\_\_\_\_

Corner Designation

SW COR. SEC. 4


Narrative:  
Corner Rpt: 67/14-10

DOUGLAS COUNTY Only  
Not a SURVEYOR  
 Renewed  
 Unrecorded  
 Surveyed In  
 Referenced Out

Previous Renewals D.C.S.O. SEPT. 1969

Monument(s) Found: (Condition and Source)

2 1/2" DIA. BRASS CAP ON 1 1/2" O.D.I.P.  
OUT OF GROUND AND WIRED VERTICAL  
TO A CEDAR FENCE POST 3 FT.  
TALL. UNMARKED STONE  
MEAS. APPROX. 15" X 6" X 2" FOUND  
LOOSE ON TOP OF GROUND BETWEEN  
FENCE POST AND BC/IP

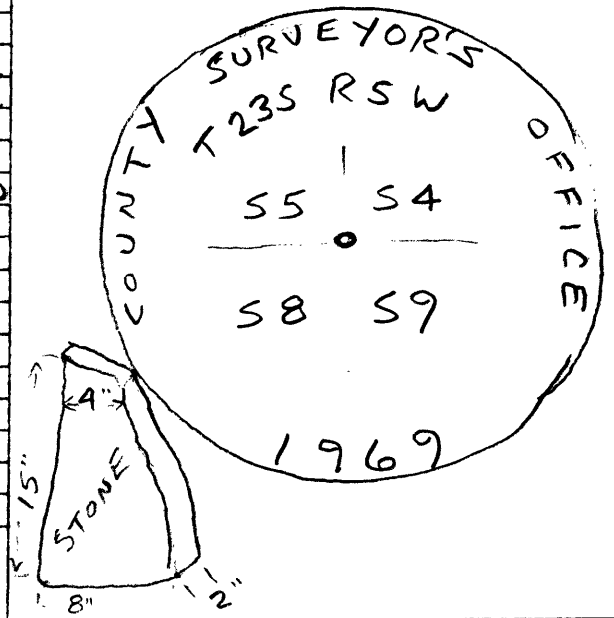

Accessories Found:

~~ORIG~~ 20" NOW 34" DIA. W. OAK, FULLY HEALED SINGLE BLAZE VISIBLE  
BEARS S 84° E, 271.3 FT. (AGREES W/REG.) 1969 BT

ORIG 12" NOW A BURNT ROTTEN STUMP STILL IN POSITION  
NO MARKINGS VISIBLE BEARS N 89° W 636 1/2 FT.  
(AGREES W/REG.) O.B.T.

~~ORIG~~ 20" B. OAK NOW A SAWN OAK STUMP 32" DIA. X 18" TALL  
EVIDENCE OF LOWER HEALED BLAZE BEARS S 43° W, 277.4 FT.  
(AGREES W/REG.) 1969 BT

C.S. File No 67/14-10

RENEWAL

Monument Set (Procedure and Description)

Monument Detail

BC/IP WAS RESET FLUSH WITH GROUND USING  
REC. INFORMATION FROM THE REMAINING 1969  
BEARING TREE AND THE TWO STUMPS.  
STONE WAS BURIED UPRIGHT, FLUSH W/GROUND ON EAST EDGE  
ADDED THE WORDS "RESET 2006" TO BC.

NOTE: IN DIGGING THE HOLE TO RESET BC/IP  
WE FOUND REMNANTS OF THE OAK FENCE  
POST CALLED OUT IN THE 1969 RENEWAL.


New Accessories

45" DIA. B. OAK, DOUBLE BLAZED & SCRIBED "T235 RSW S5CS BT"  
BEARS WEST, 564.9 FT.

19" DIA. D. FIR, DOUBLE BLAZED & SCRIBED "T235 RSW S4CS BT"  
BEARS S 59 1/2° W 345.9 FT.

9" MADRONE, DOUBLE BLAZED & SCRIBED "T235 RSW S4CS BT"  
BEARS N 81 1/4° E, 436.9 FT.

Sketch of Monument, Accessories, and General Area

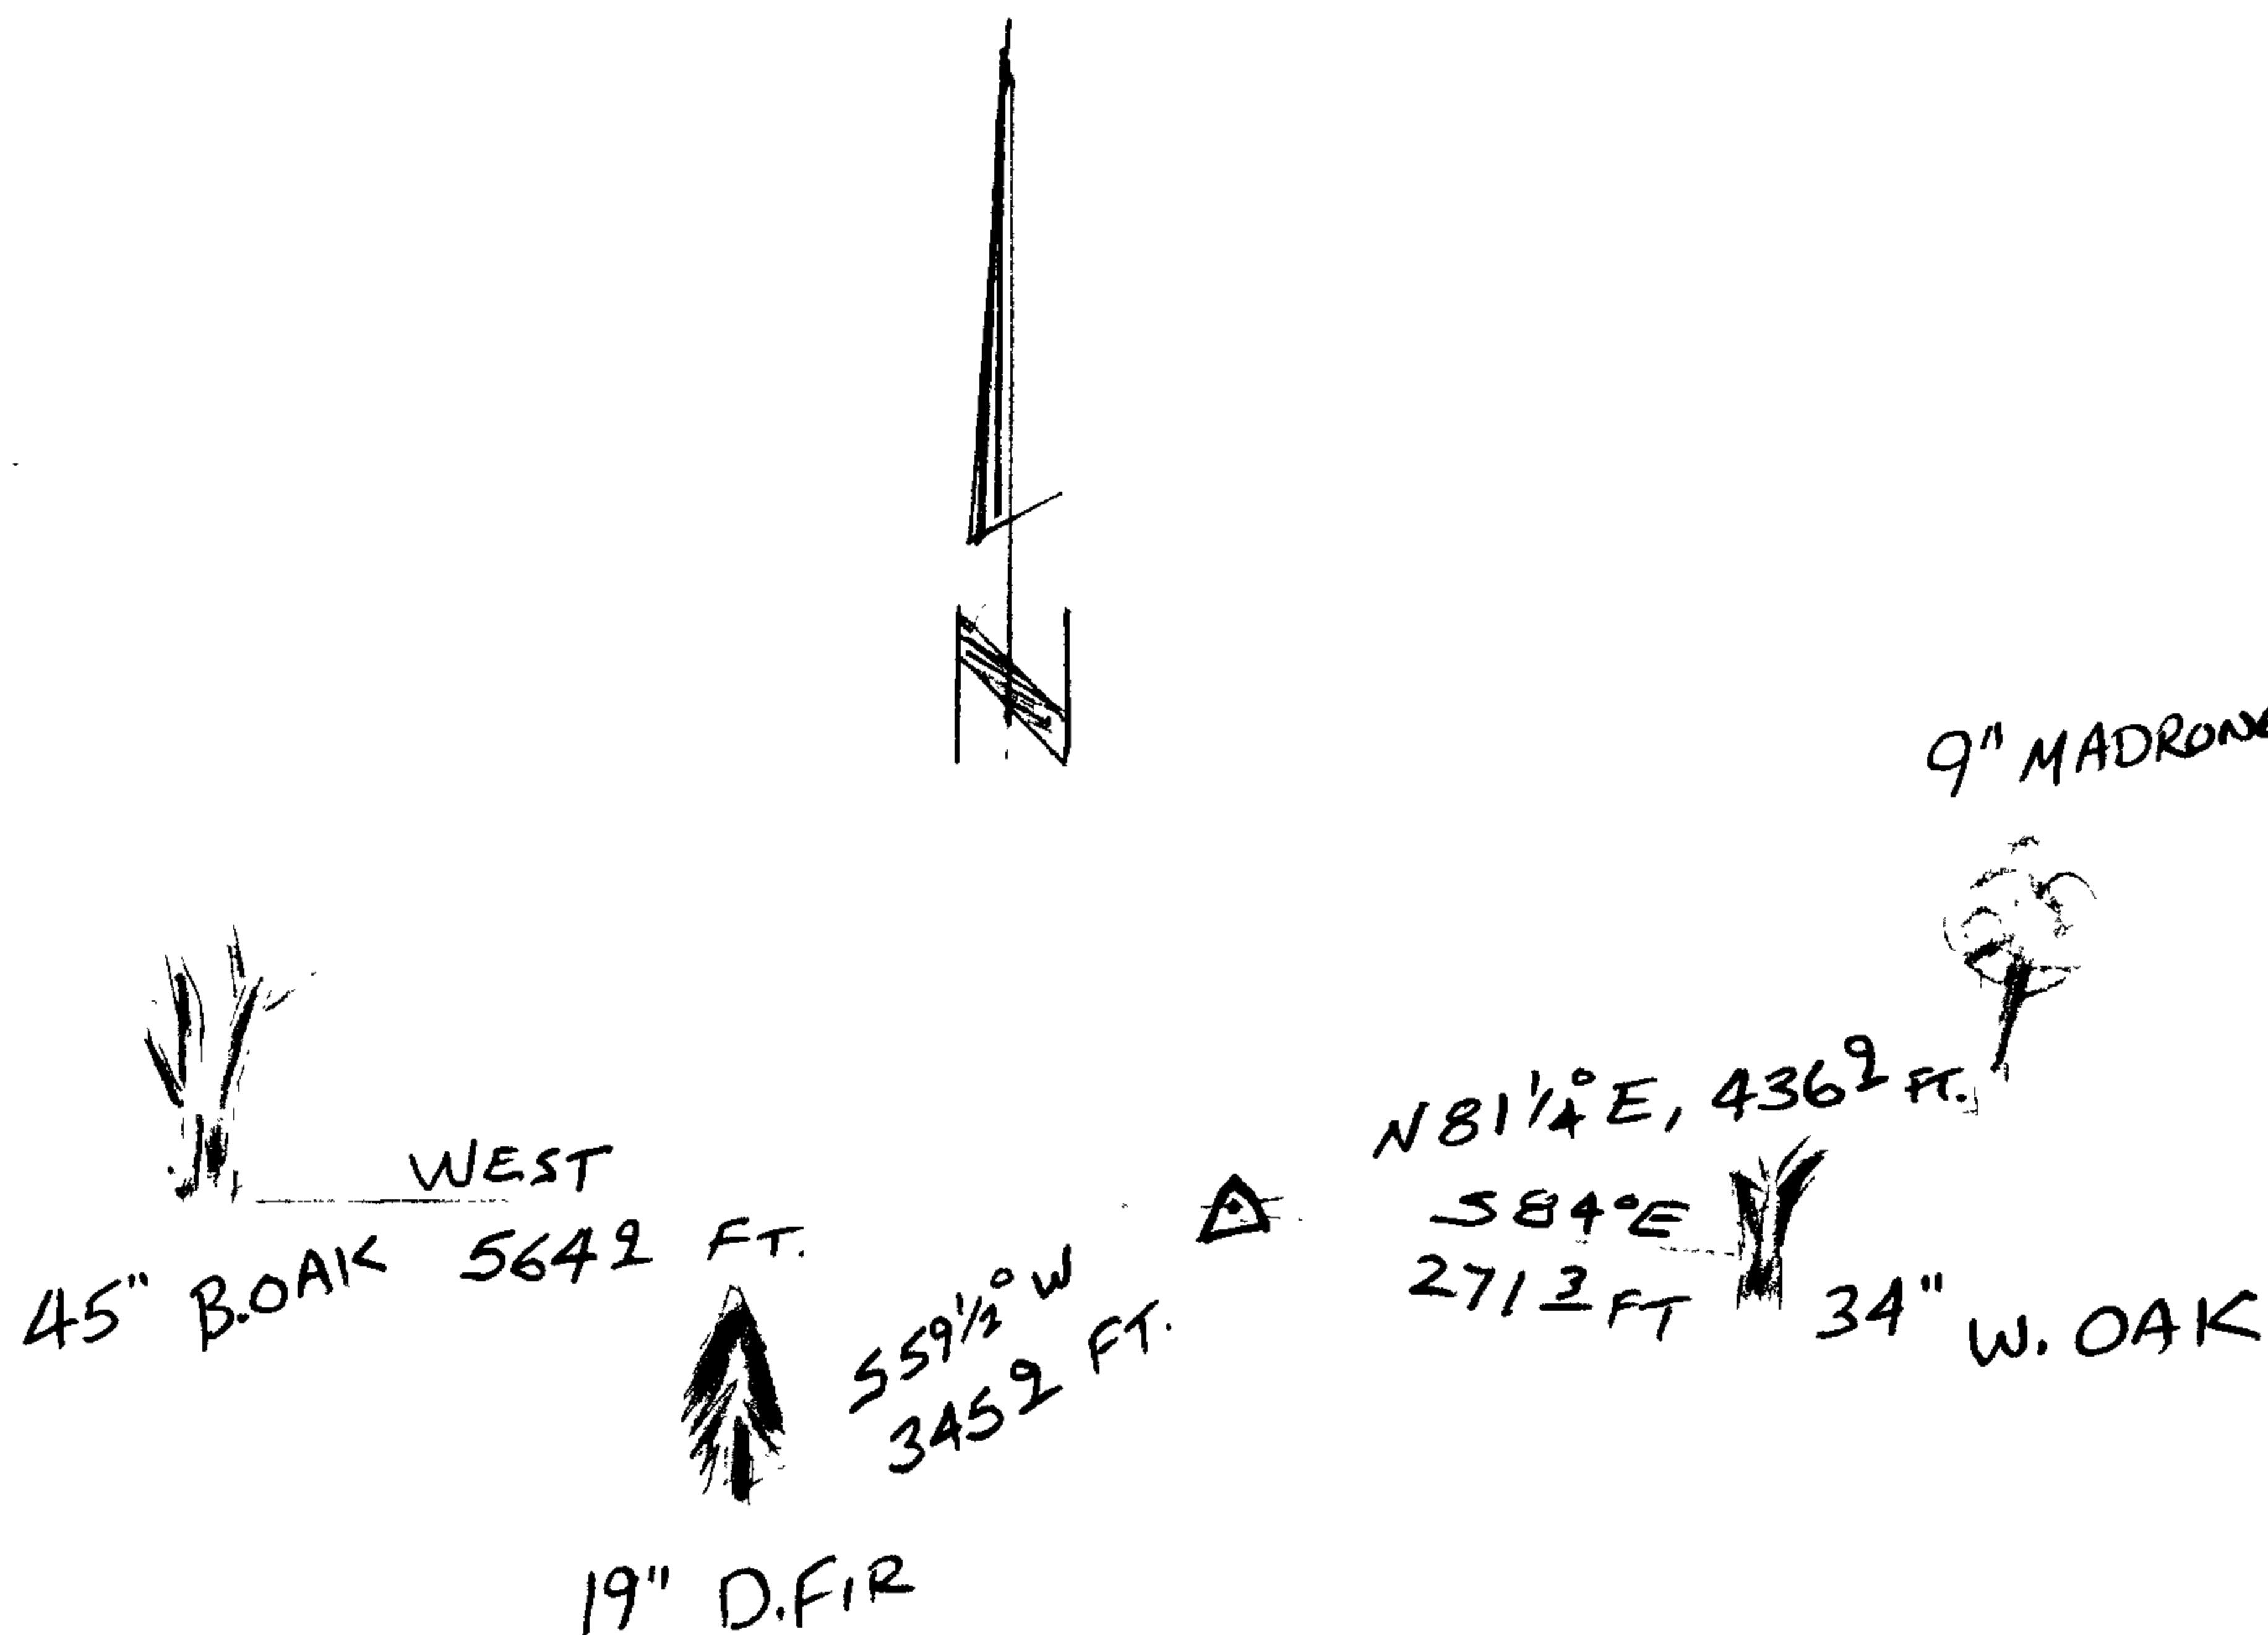

Location & Comments

CORNER LIES IN CLEARED  
PASTURE LAND ROLLING  
TERRAIN, 8" SOUTHERLY  
OF 3 FT. TALL CEDAR  
FENCE POST.

CO41216A

Comp. Declin. 16 1/4° E  
Agency D. C. S. O.  
Party Chief S. FLAUSE  
Notekeeper J. PIKE  
Witnesses

Address

Surveyor's Seal  
REGISTERED  
PROFESSIONAL  
LAND SURVEYOR  
*Randall W. Smith*  
RONALD 6-30-07  
OREGON  
JULY 25, 1997  
RANDALL W. SMITH  
2488