

FILED

GOVERNMENT CORNER RESTORATION FORM


Date: 6/8/06 By: JC

This survey consists of:

Township 21 S Range 4 W Sec. 19 County DOUGLAS Map: _____

State OR Date 6-5-06 No. 140300 Narrative: _____
Corner Rpt: 67/14-16

Corner Designation

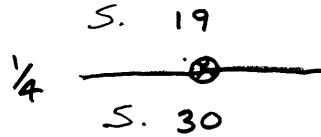

DOUGLAS COUNTY SURVEYOR


- Condition Report Only
- Not Found
- Renewed
- Unrecorded
- Surveyed In
- Referenced Out

Previous Renewals BRIGGS 1891; FOLLETT 1950; SHANER 1962

MONUMENT DETAIL

Monument(s) Found: (Condition and Source)

5/8" DIA BOLT W/ 1 1/4" SQUARE HEAD. BOLT LIES IN DEPRESSION AT BASE OF S.E. BEARING TREE.

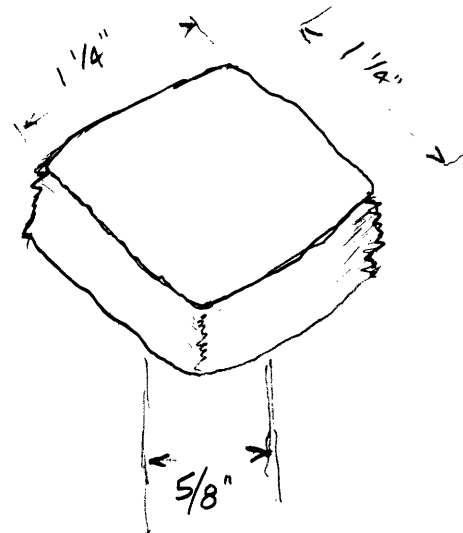

Accessories Found:

24" D. FIR NOW 47" DIA. HEALED BLAZE VISIBLE
~~52° E 2.8 FT (REC. S20° E, 2.8 FT.) 1962 BT~~
AGREES WITH RECORD

18" D. FIR NOW 17" DIA. X 4 FT. TALL ROTTING STUMP.
BLAZE IS CHOPPED OUT, AND SCRIBING "1/4 S BT" IS VISIBLE.
BEARS N 74° W, 30.2 FT. (AGREES W/ RECORD) 1962 BT

POWER POLE A3379 IS NOW A ROTTED STUB WITH NEW POWER POLE
TO EAST. STUB BEARS N 0° 30' W 45.3 FT. (REC. N 0° 30' W
46.3; REC. DIST COULD BE SLOPE DIST.) 1950 BO

- NO TRACE OF ANY OTHER BEARING TREES OF RECORD.

C.S. File No 67/14-16

