


GOVERNMENT CORNER RESTORATION FORM

Date: ~~7-10-2006~~ By: SC

Township 225 Range 8W Sec. 28 County DOUGLAS This survey consists of:

State OR Date JUNE 14, 2006 No. 300249 Map: _____

Corner Designation

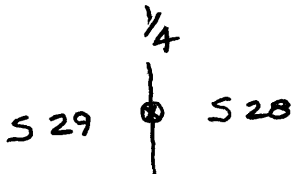

Narrative: _____

Corner Rpt: 67/14-18

DOUGLAS COUNTY


- Condition Survey Only
- Not Found
- Renewed
- Unrecorded
- Surveyed In
- Referenced Out

MONUMENT DETAIL

Previous Renewals GLO 1081; BLM 1965

Monument(s) Found: (Condition and Source)

BLM BRASS CAP 3" DIA. ON IRON PIPE BURIED 36" DEEP

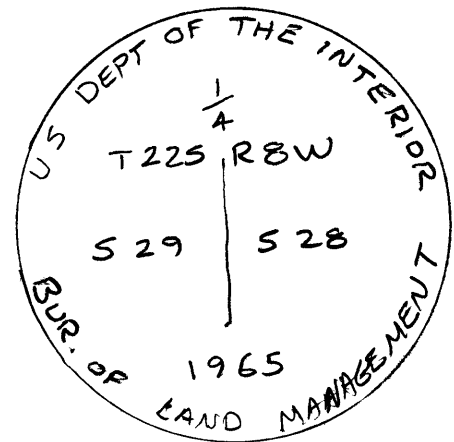

Accessories Found:

- 10" DIA. D. FIR NW 16" DIA. X 2 FT. TALL
ROTTING STUMP, SINGLE BLAZE VISIBLE
BEARS S 48 1/2° E, 412.5 FT. (AGREES W/REG.) BLM 1965

- NO TRACE OF BLM 1965 NW BEARING TREE. POSITION
FALLS IN SAWYER CRK. (REG. N 16 3/4° W, 184.1 FT.)

