

FILED

GOVERNMENT CORNER RESTORATION FORM

Date: 7-10-2006 By: XC

Township 26 S Range 3 W Sec. 17

County DOUGLAS

This survey consists of:

State OR

Date 6-22-2006

No. 041030

Map: _____

Narrative: _____

Corner Rpt: 67/14-21

Corner Designation

SW COR WELKER
DLC No 41

DOUGLAS COUNTY

SURVEYOR


- Condition Report Only
- Not Found
- Renewed
- Unrecorded
- Surveyed In
- Referenced Out

MONUMENT DETAIL

Previous Renewals 1930, 1941, 1966

Monument(s) Found: (Condition and Source)

2 1/2" BC ON I.P. (MARKED AS SHOWN) 8" BELOW SURFACE OF GROUND.

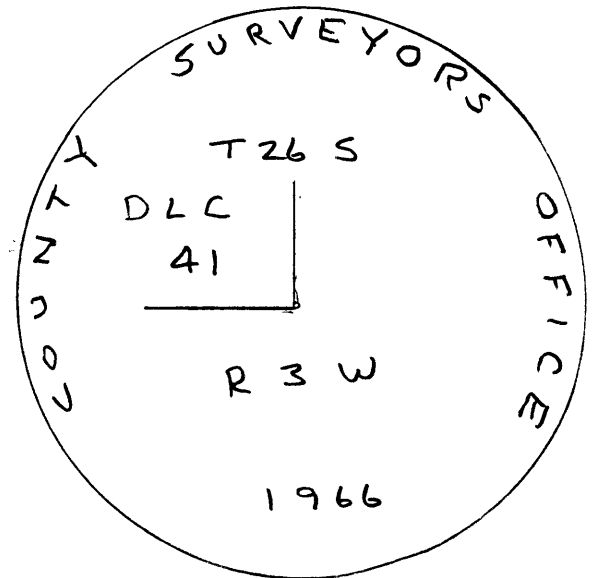

Accessories Found:

15" FIR Now 34" DIA. X 1 FT. TALL
DECOMPOSED STUMP ARE MARKS VISIBLE ON LOWER PART OF EXPOSED FACE. BEARS S 14 1/2° W, 492 FT.
(AGREES W/REC.) 1930 BT

- 1" DIA. IRON PIPE WITH 2 ELBOWS AT SE COR. DLC 41 BEARS North, 66.0 FT.
(AGREES W/REC.)

C.S. File No 67/14-21

