

FILED

GOVERNMENT CORNER RESTORATION FORM

Date: 7-10-2006 By: JC

Township 26 S Range 3 W Sec. 17

County DOUGLAS

This survey consists of:  
Map: \_\_\_\_\_

State OR Date 6-22-2006

No. 040060 Narrative: \_\_\_\_\_

Corner Rpt: 67/14-22

Corner Designation

SE COR. FRENCH DLC NO 40


DOUGLAS COUNTY

- Condition Report Only
- Not Found
- Renewed
- Unrecorded
- Surveyed In
- Referenced Out

Previous Renewals 1941, 1966

Monument(s) Found: (Condition and Source)

1" O.D. IRON PIPE WITH 2  
ELBOWS ATTACHED 6" BELOW  
SURFACE OF GROUND

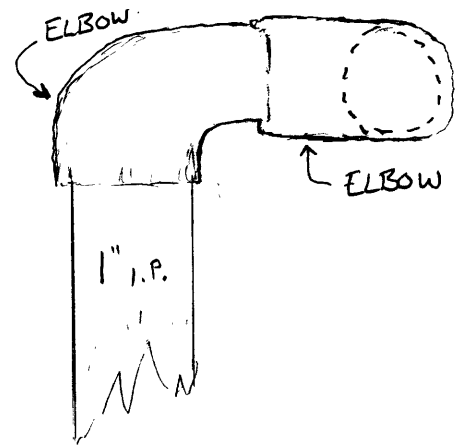

MONUMENT DETAIL

Accessories Found:

9" DIA. B. OAK (1966) NOW 14" DIA. IS MOST WESTERLY TRUNK  
OF A TRIPLE TRUNK TREE. EVIDENCE OF FULLY HEALED  
BLAZE. THE BASE OF SCRIBED TRUNK BEARS S65°W,  
4.4 FT. (AGREES W/REC.) CENTER OF TRIPLE TRUNK  
ROOT CROWN BEARS S61°W, 3.1 FT.

- BC/IP AT SW COR. DLC 41 BEARS SOUTH, 66° FT. (AGREES W/REC.)

- NO TRACE OF ANY OTHER BT'S NOTED.

