

FILED

GOVERNMENT CORNER RESTORATION FORM

Date: 8-17-2006 By: JC

This survey consists of: 1

Township 22S Range 8W Sec. 28 County DOUGLAS Map: \_\_\_\_\_

State OREGON Date JUNE 21, 2006 No. 045080 Narrative: \_\_\_\_\_  
Corner Rpt: 67/14-24

Corner Designation

SE COR JOHN SAWYER  
DLC NO 45

DOUGLAS COUNTY  
SURVEYOR

- Condition Report Only
- Not Found
- Renewed
- Unrecorded
- Surveyed In
- Referenced Out


MONUMENT DETAIL

Previous Renewals

Monument(s) Found: (Condition and Source)

- 3/4" DIA. BRASS CAP ON 2 1/2" DIA  
IRON PIPE. FIRMLY SET. PROJECTS  
4" ABOVE GROUND.

- A 1" O.D. IRON PIPE. PROJECTING 15"  
ABOVE GROUND IS FOUND ON WEST  
EDGE OF BC/IP. - NO PREVIOUS REC. -

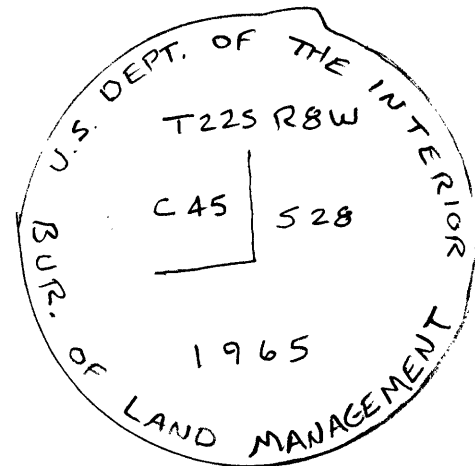

Accessories Found:

5" DIA. W. FIR (1965) NOW 18" DIA. x 2 FT. TALL ROTTING  
STUMP, EVID. OF HEALED BLAZE BEARS N 44 1/4° E, 42.6 FT.  
(AGREES W/REC.)

C.S. File No 67/14-24

