

FILED

GOVERNMENT CORNER RESTORATION FORM

Date: 10-9-2006 By: JC

Township 27S Range 7W Sec. 24 County DOUGLAS

This survey consists of:

State OR Date 9-21-06 No. 048050

Map: _____

Narrative: _____

Corner Rpt: 67/14-26

Corner Designation

INT L CORNER
DLC # 48

DOUGLAS COUNTY
SURVEYOR


- Condition Report Only
- Not Found
- Renewed
- Unrecorded
- Surveyed In
- Referenced Out

Previous Renewals 1914, 1968, 1999

Monument(s) Found: (Condition and Source)

AS PER 1999 RENEWAL

MONUMENT DETAIL

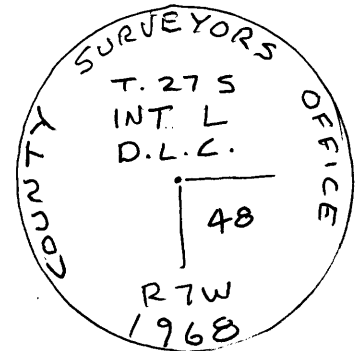

Accessories Found:

15" Now 20" DIA. D. FIR, FULLY HEALED DOUBLE BLAZE
VISIBLE, BEARS S 43°W, 54.0 FT. AGREES W/REC. 1968 BT

15" Now 16" DIA. PINE, MOSTLY HEALED DOUBLE BLAZE VISIBLE
BEARS S 9°E 7.7 FT. AGREES W/REC. 1999 BT

13" Now 14" DIA. W. OAK, HEALED DOUBLE BLAZE VISIBLE
BEARS N 20°W 26 3/4 FT. AGREES W/REC. 1999 BT

20" DIA. W. OAK STUMP IS AS FOUND IN 1999 REN. O.B.T.

11" D. FIR Now 11" DIA STUMP CUT FLUSH W/GROUND. BEARS
N 33 1/2° E, 69.9 FT. AGREES W/REC. 1968 BT

C.S. File No 67/14-26

