

GOVERNMENT CORNER RESTORATION FORM

e: 10-18-2006 Rv: JC

Township 27S Range 7W Sec. 24

County DOUGLAS

This survey consists of:

State OR

Date SEPT. 25, 2006

No. 640300

Map: \_\_\_\_\_

Corner Rpt: 67/A-27

Corner Designation

	S	24
$\frac{1}{4}$	<u>X</u>	
	S	25

DOUGLAS COUNTY

Condition Report Only

Not Found

Renewed

Unrecorded

Surveyed In


Referenced Out

MONUMENT DETAIL

Previous Renewals 1914, 1969

Monument(s) Found: (Condition and Source)

2 1/2" BRASS CAP PROPERLY MARKED  
FIRMLY SET, PROJECTS FROM  
GROUND 10"

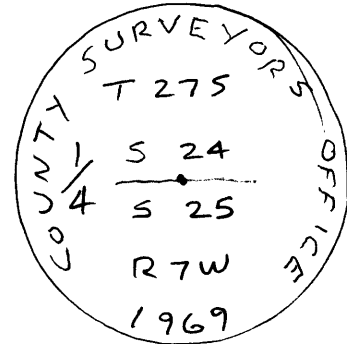

Accessories Found:

ORIG 12" Now VERY ROTTED B.OAK STAMP. APPROX. 3 FT TALL  
BEARS N 30° W, 25° FT. (AGREES W/REC.) O.B.T.

ORIG. 24" B. OAK, Now VERY BADLY DECAYED & LYING ON GROUND  
CHECKS OK FOR POSITION (S 38° W, 43° FT.) O.B.T.

18" Now 26" DIA. D. FIR, FULLY HEALED DOUBLE BLAZE VISIBLE  
BEARS S 12° E, 7 1/2 FT. (AGREES W/REC) 1969 BT

13" Now 16" DIA. X 2 FT. TALL D. FIR STUMP. BEARS N 60° E, 36.2 FT.  
(AGREES W/REC.) 1969 BT

C.S. File No 67/A-27

