




RENEWAL

Monument Set (Procedure and Description)

Monument Detail


2 1/2" B.C. (MARKED AS SHOWN) ON  
 1 1/4" O.D. IRON PIPE 30" IN LENGTH.  
 PROJECTS 8" ABOVE GROUND.  
 MONUMENT WAS RESET BY A DISTANCE-  
 DISTANCE INTERSECT FROM REMAINING  
 1969 ACCESSORIES. COULD NOT MATCH  
 RECORD BEARINGS TO 1969 ACCESSORIES  
 POSSIBLY DUE TO MAGNETIC ATTRACTION  
 OF FENCES AT CORNER POSITION.

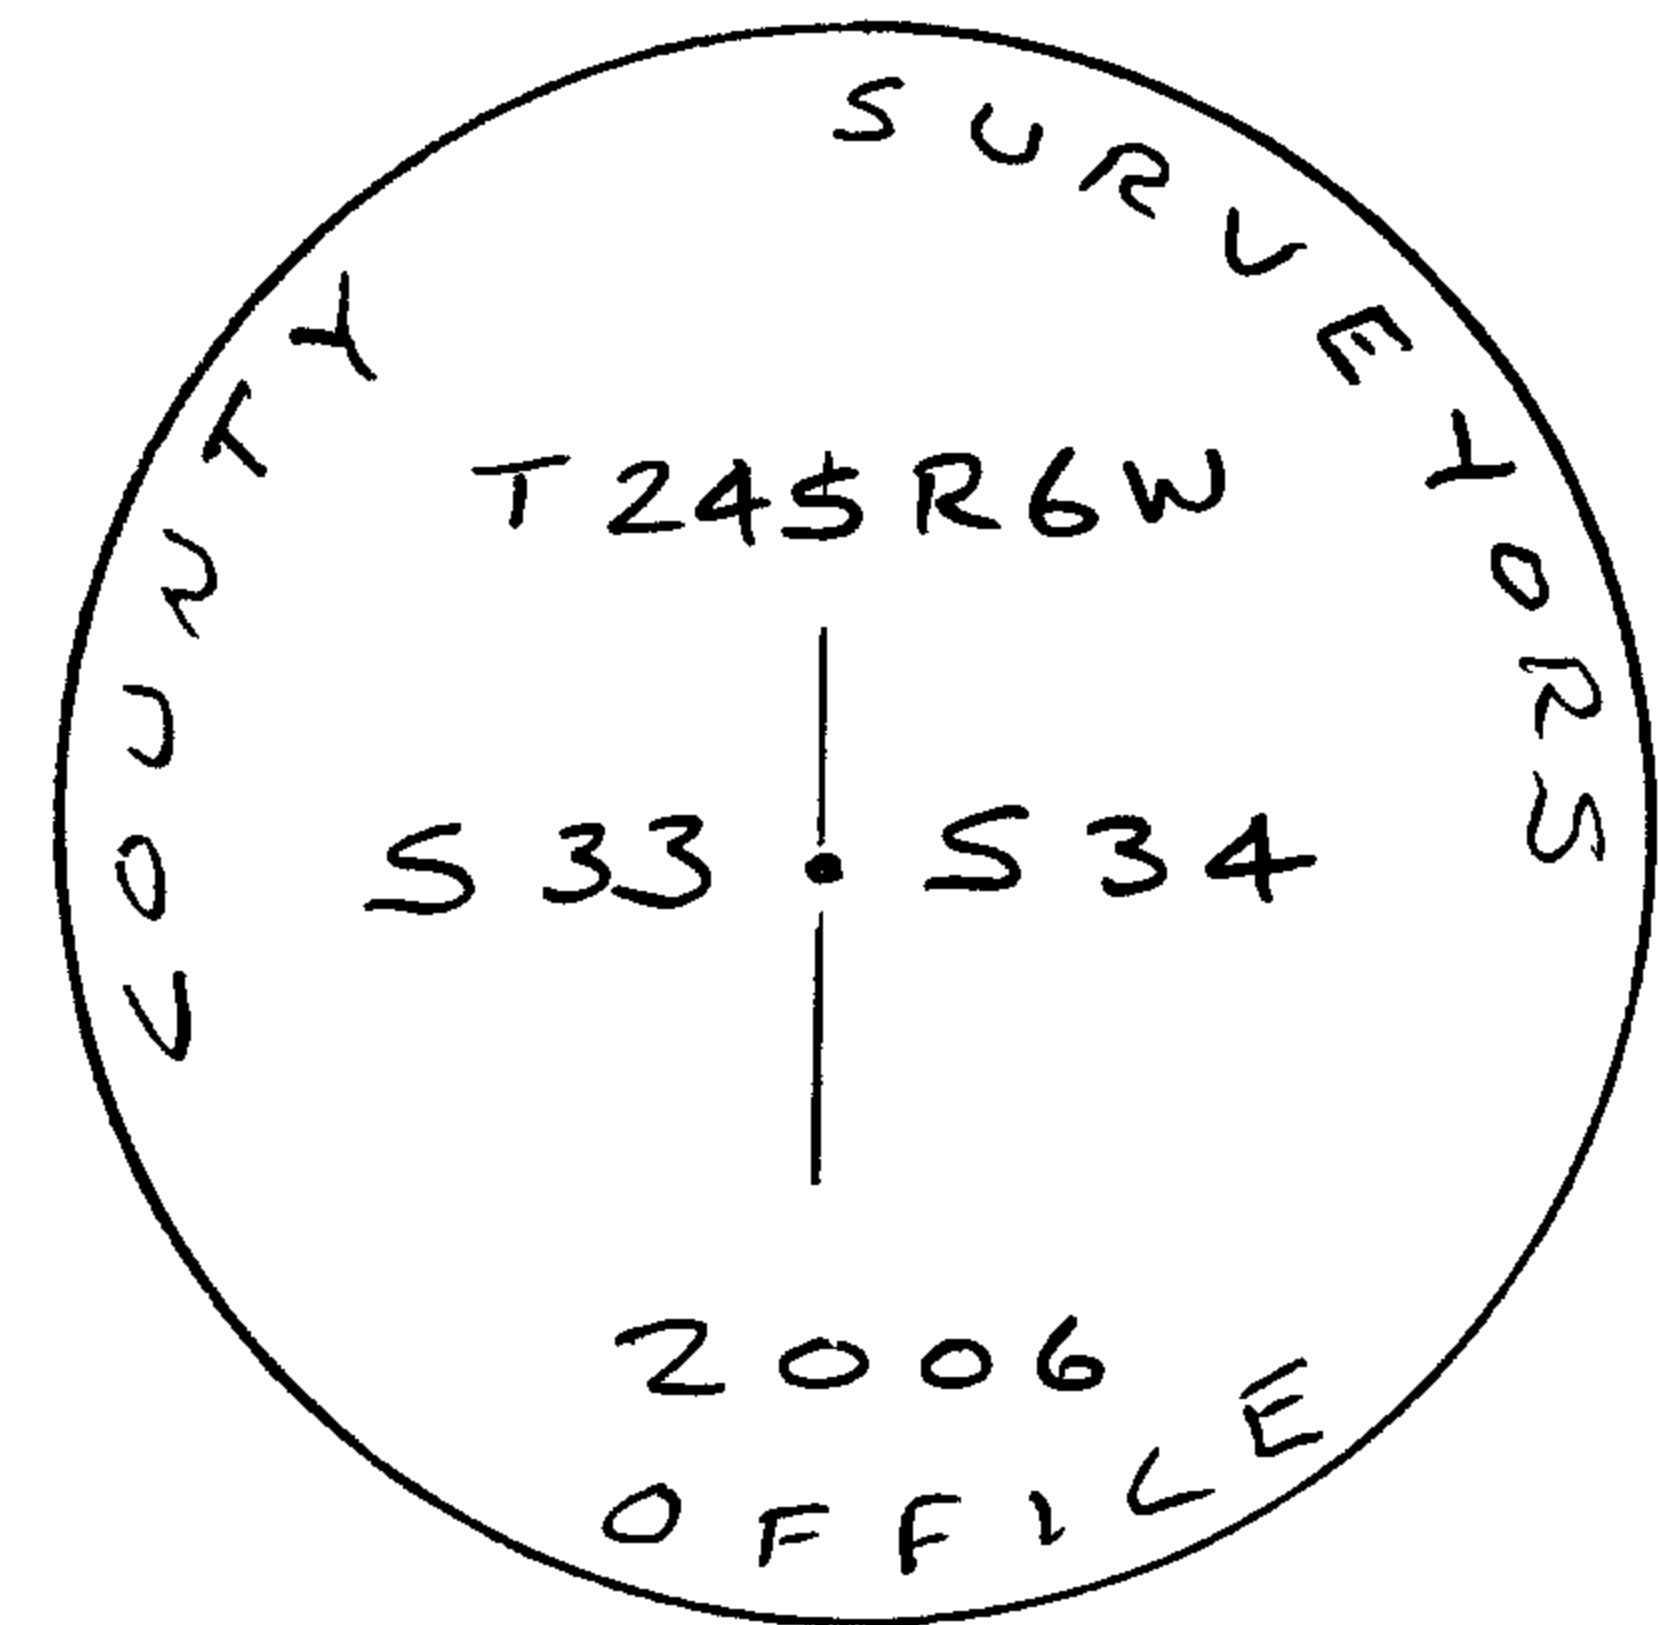

New Accessories

- 26" DIA. D. FIR, DOUBLE BLAZED & SCRIBED "1/4 S 34 CS BT" BEARS N 69° E, 49.3 FT.
- 12" DIA. OREGON ASH, DOUBLE BLAZED & SCRIBED "1/4 S 34 CS BT" BEARS S 39° E, 40.5 FT.
- 23" DIA. I. CEDAR, DOUBLE BLAZED & SCRIBED "1/4 S 33 CS BT" BEARS S 37° W, 13.6 FT.

Sketch of Monument, Accessories, and General Area

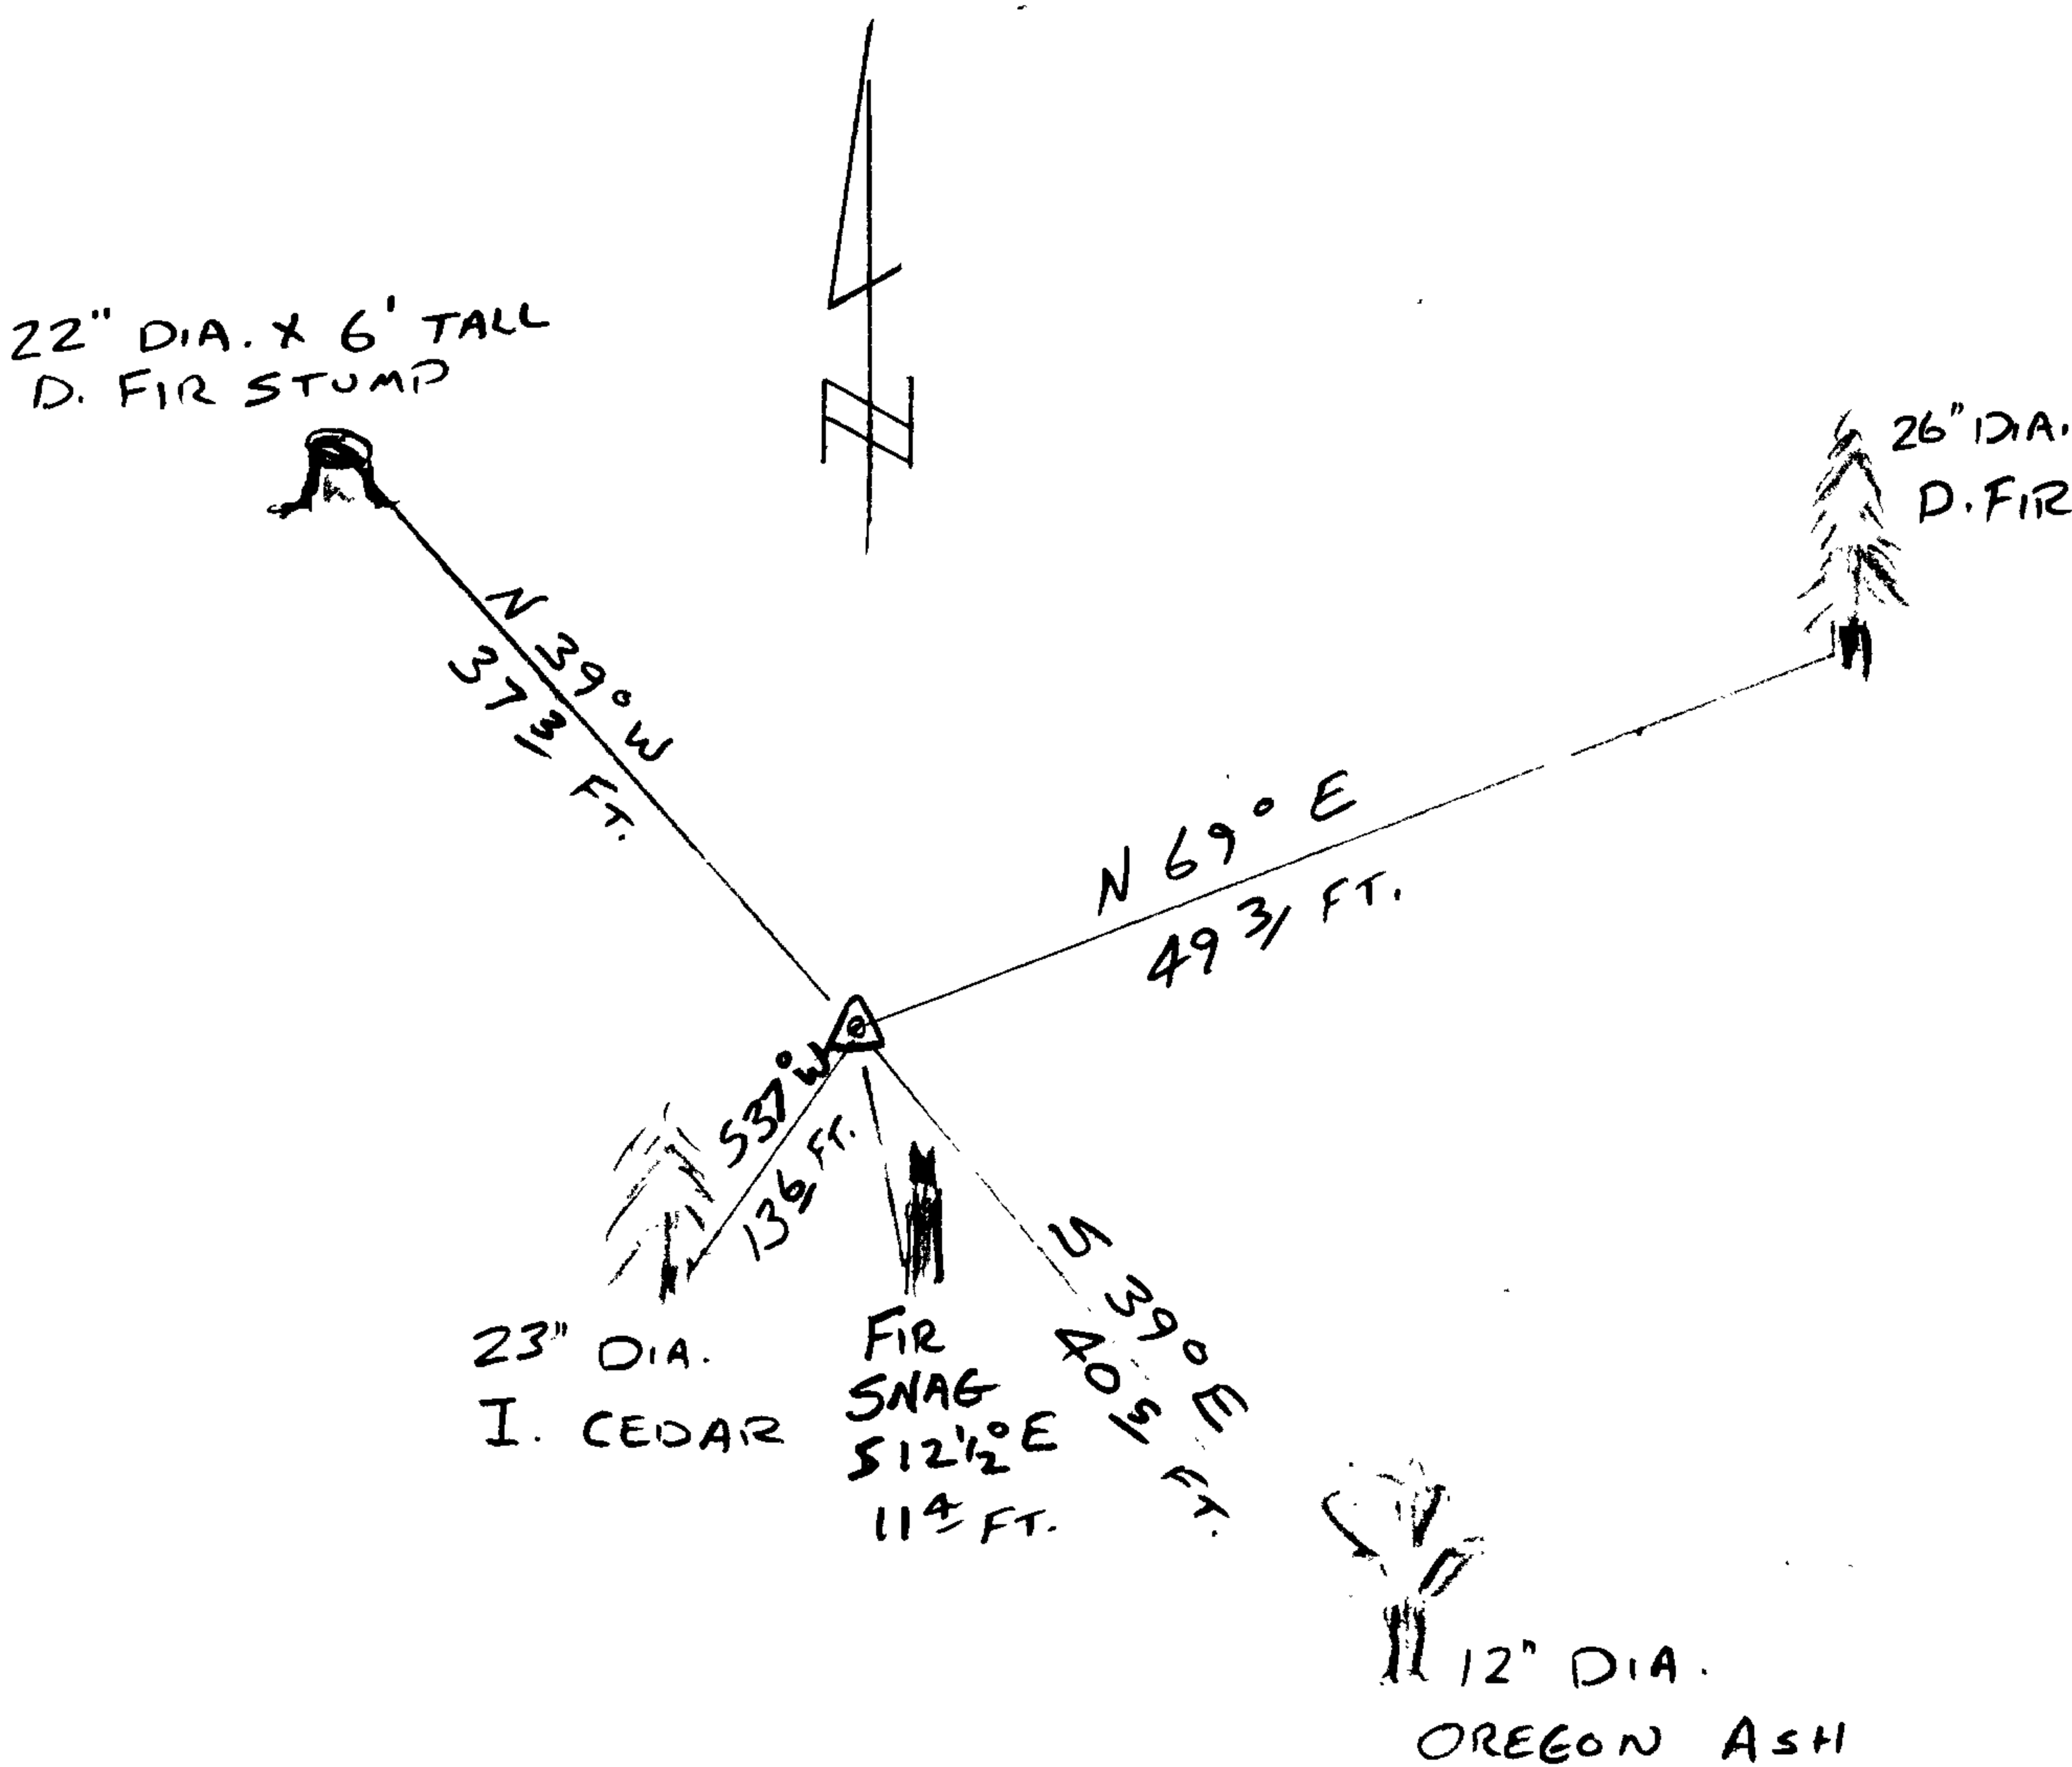

Location & Comments

APROX. 350 FT. SOUTHERLY OF  
 HWY 138 ON GENTLE NORTH  
 FACING SLOPE. APROX. 1.3  
 FT. NORTH OF DILAPIDATED  
 FENCE CORNER WITH FENCES  
 EXTENDING SOUTH & EAST

C092512A

Comp. Declin. 16 1/2° E  
 Agency D.C.S.O.  
 Party Chief S. FLAUSE  
 Notekeeper J. PIKE  
 Witnesses

Address

Surveyor's Seal  
**REGISTERED  
 PROFESSIONAL  
 LAND SURVEYOR**

*Randall W. Smith*  
 RENEWAL 6-30-08

OREGON  
 JULY 25, 1999  
**RANDALL W. SMITH**  
 2489

67/14-24