

GOVERNMENT CORNER RESTORATION FORM

FILED

Township 27 S Range S W Sec. 19 ^{SW COR} County DOUGLAS Date SEPT 28, 06 No. 100300 This survey consists of: Map: _____
Narrative: _____
Corner Rpt: 67/14-30

Corner Designation _____


24 | 19
*
25 | 30

DOUGLAS COUNTY
Condition: SURVEYOR Only
 Not Found
 Renewed
 Unrecorded
 Surveyed In
 Referenced Out

Previous Renewals 1938, 1957

Monument(s) Found: (Condition and Source)

2 1/2" DIA BRASS CAP PROPERLY MARKED IS FOUND PART WAY UNDER 18" RED BRICK WALL. WALL IS NOW LEANING WESTERLY AND PARTIALLY COVERS BC.

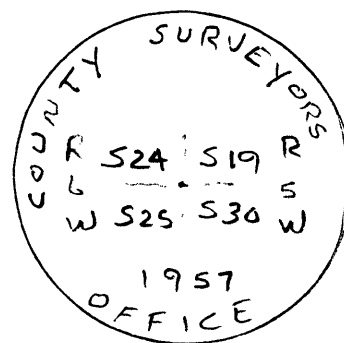

Accessories Found:

- BRASS CAP IS FOUND S 42° W, 1.4 FT FROM INSIDE CORNER OF AN 18" TALL RED BRICK WALL (SEE SKETCH) (REC. S 34° 27' 50" E, 1.4 FT. AND S 55° 30' 10" W, 0.2 FT.) 1957
- STREET MONUMENT AT INTERSECTION OF RICE ST & MAIN ST. BEARS S 67° W, 229.7 FT. (REC. S 67° 06' W, 229.7 FT.) 1938
AGREES WITH RECORD

ALS
10-12-06

C.S. File No 67/14-30

