

GOVERNMENT CORNER RESTORATION FORM

Date: 10-18-2006 By: J


This survey consists of:

Township 33S Range 6W Sec. 4 County DOUGLAS Map: _____

State OR Date OCT 10, 2006 No. 300640 Corner Pt: 67/14-31

Corner Designation

DOUGLAS COUNTY SURVEYOR

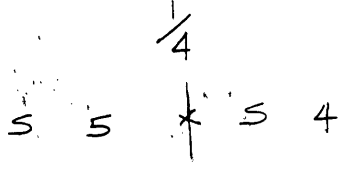

- Condition Report Only
- Not Found
- Renewed
- Unrecorded
- Surveyed In
- Referenced Out

Previous Renewals 1923, 1946, 1962

MONUMENT DETAIL

Monument(s) Found: (Condition and Source)

2" I.D. IRON PIPE 4" BELOW GROUND
 W/ 3 FT. TALL STEEL FENCE POST
 0.5 FT. EAST. 1923

1" I.D. IRON PIPE PROJECTS 2" ABOVE
 GROUND BEARS N 1° W 3.05 FT.
 NO PREVIOUS RECORD FOUND

Accessories Found:

18" NOW 37" D.I.A. D. FIR FULLY HEALED DOUBLE BLAZE VISIBLE
 BEARS S 46° E, 29.8 FT. (REC. S 41° 04' E, 29.8 FT.) 1962 BT

20" FIR NOW VERY ROTTED 1 FT. TALL STUMP BEARS S 72° W, 34.3 FT.
 (AGREES W/REC.) 1946 BT

NO TRACE OF ANY OTHER ACCESSORIES FOUND.

