

Date: 11/9/06 By: LC

GOVERNMENT CORNER RESTORATION FORM

This survey consists of:

Township 30 S Range 5 W Sec. 31

County Douglas

State OR

Date OCT. 18, 2006

No. 200100

Map: _____

Narrative: _____

Corner File: 67/14-34

Corner Designation

DOUGLAS COUNTY SURVEYOR

SEC. CORNER FOR 531 | 532
31 & 32 ONLY
S. LINE OF T-SHIP

- Condition Report Only
- Not Found
- Renewed
- Unrecorded
- Surveyed In
- Referenced Out

Previous Renewals 1946, 1959, 1979

MONUMENT DETAIL

Monument(s) Found: (Condition and Source)

WENDEROTH'S POSITION

2 1/2" DIA B.C., WITH ALL MARKINGS
OBLITERATED, ON 1 1/4" O.D. IRON PIPE
PROJECTS 14" ABOVE GROUND. SET BY
JAMES BYRON ON DEC. 28, 1959
(C.S. FILE 46/64) 3/4" I.D. I.P. PIPE IS FOUND
BENT OVER DOWNHILL, EASTERLY

INGRAMS POSITION

2 1/2" DIA. B.C. MARKED AS PER RECORD
SET BY D.C.S.O. ON 6/12/79 (RM 3-26)
IT WAS DETERMINED BY THIS OFFICE TO
OBLITERATE THIS COR. POSITION DUE TO THE FACT
WENDEROTH IN 1946 ESTABLISHED THIS CORNER FROM
A FOUND ORIG. B.T. (1946 REN.) THEREFORE WE ACCEPT
WENDEROTH'S POSITION AND SAW OFF INGRAM'S
1979 B.C. LEAVING A 1" I.D. IRON PIPE
PROJECTING 4" ABOVE GROUND.

Accessories Found:

WENDEROTH'S POSITION ; ACCESSORIES PER 1979 REN.

- 14" x 10' TALL SNAG NOW 14" DIA. X 6 FT. TALL SNAG, VERY ROTTED
CHOPPED OUT BLAZES VISIBLE, BEARS S 26 1/2° W, 15.4 FT. (AGREES W/1979 REC.) 1946
- 12" x 15' TALL SNAG NOW 15" DIA. X 4 FT. TALL SNAG, VERY ROTTED
CHOPPED OUT BLAZES VISIBLE, BEARS S 33° E, 22.0 FT. (AGREES W/1979 REC.) 1946
- 26" DIA. STUMP NOW INDETERMINATE SIZE STUMP, CHOPPED OUT LOWER BLAZE
BEARS N 32 1/2° W, 98.0 FT. (AGREES W/1979 REC.) 1946 BT
- 8" DIA. WINDFALL NOW VERY ROTTED WITH NEW WINDFALL ON TOP, CHOPPED OUT BLAZE
BEARS N 4 1/3° E, 43.8 FT. (AGREES W/1979 REC.) 1946 BT
- 24" DIA. NOW 20" DIA. X 4 FT. TALL ROTTED STUMP BEARS S 85° E, 11.7 FT. (AGREES W/
1959 BT 1979 REC.)


ALL 1979 ACCESSORIES WERE FOUND AND OBLITERATED THAT
WERE REFERENCING INGRAM'S POSITION.

RENEWAL

Monument Set (Procedure and Description)

Monument Detail


BRASS CAP AT WENDEROTH'S POSITION
 WAS FILED SMOOTH AND RESTAMPED
 (AS SHOWN)

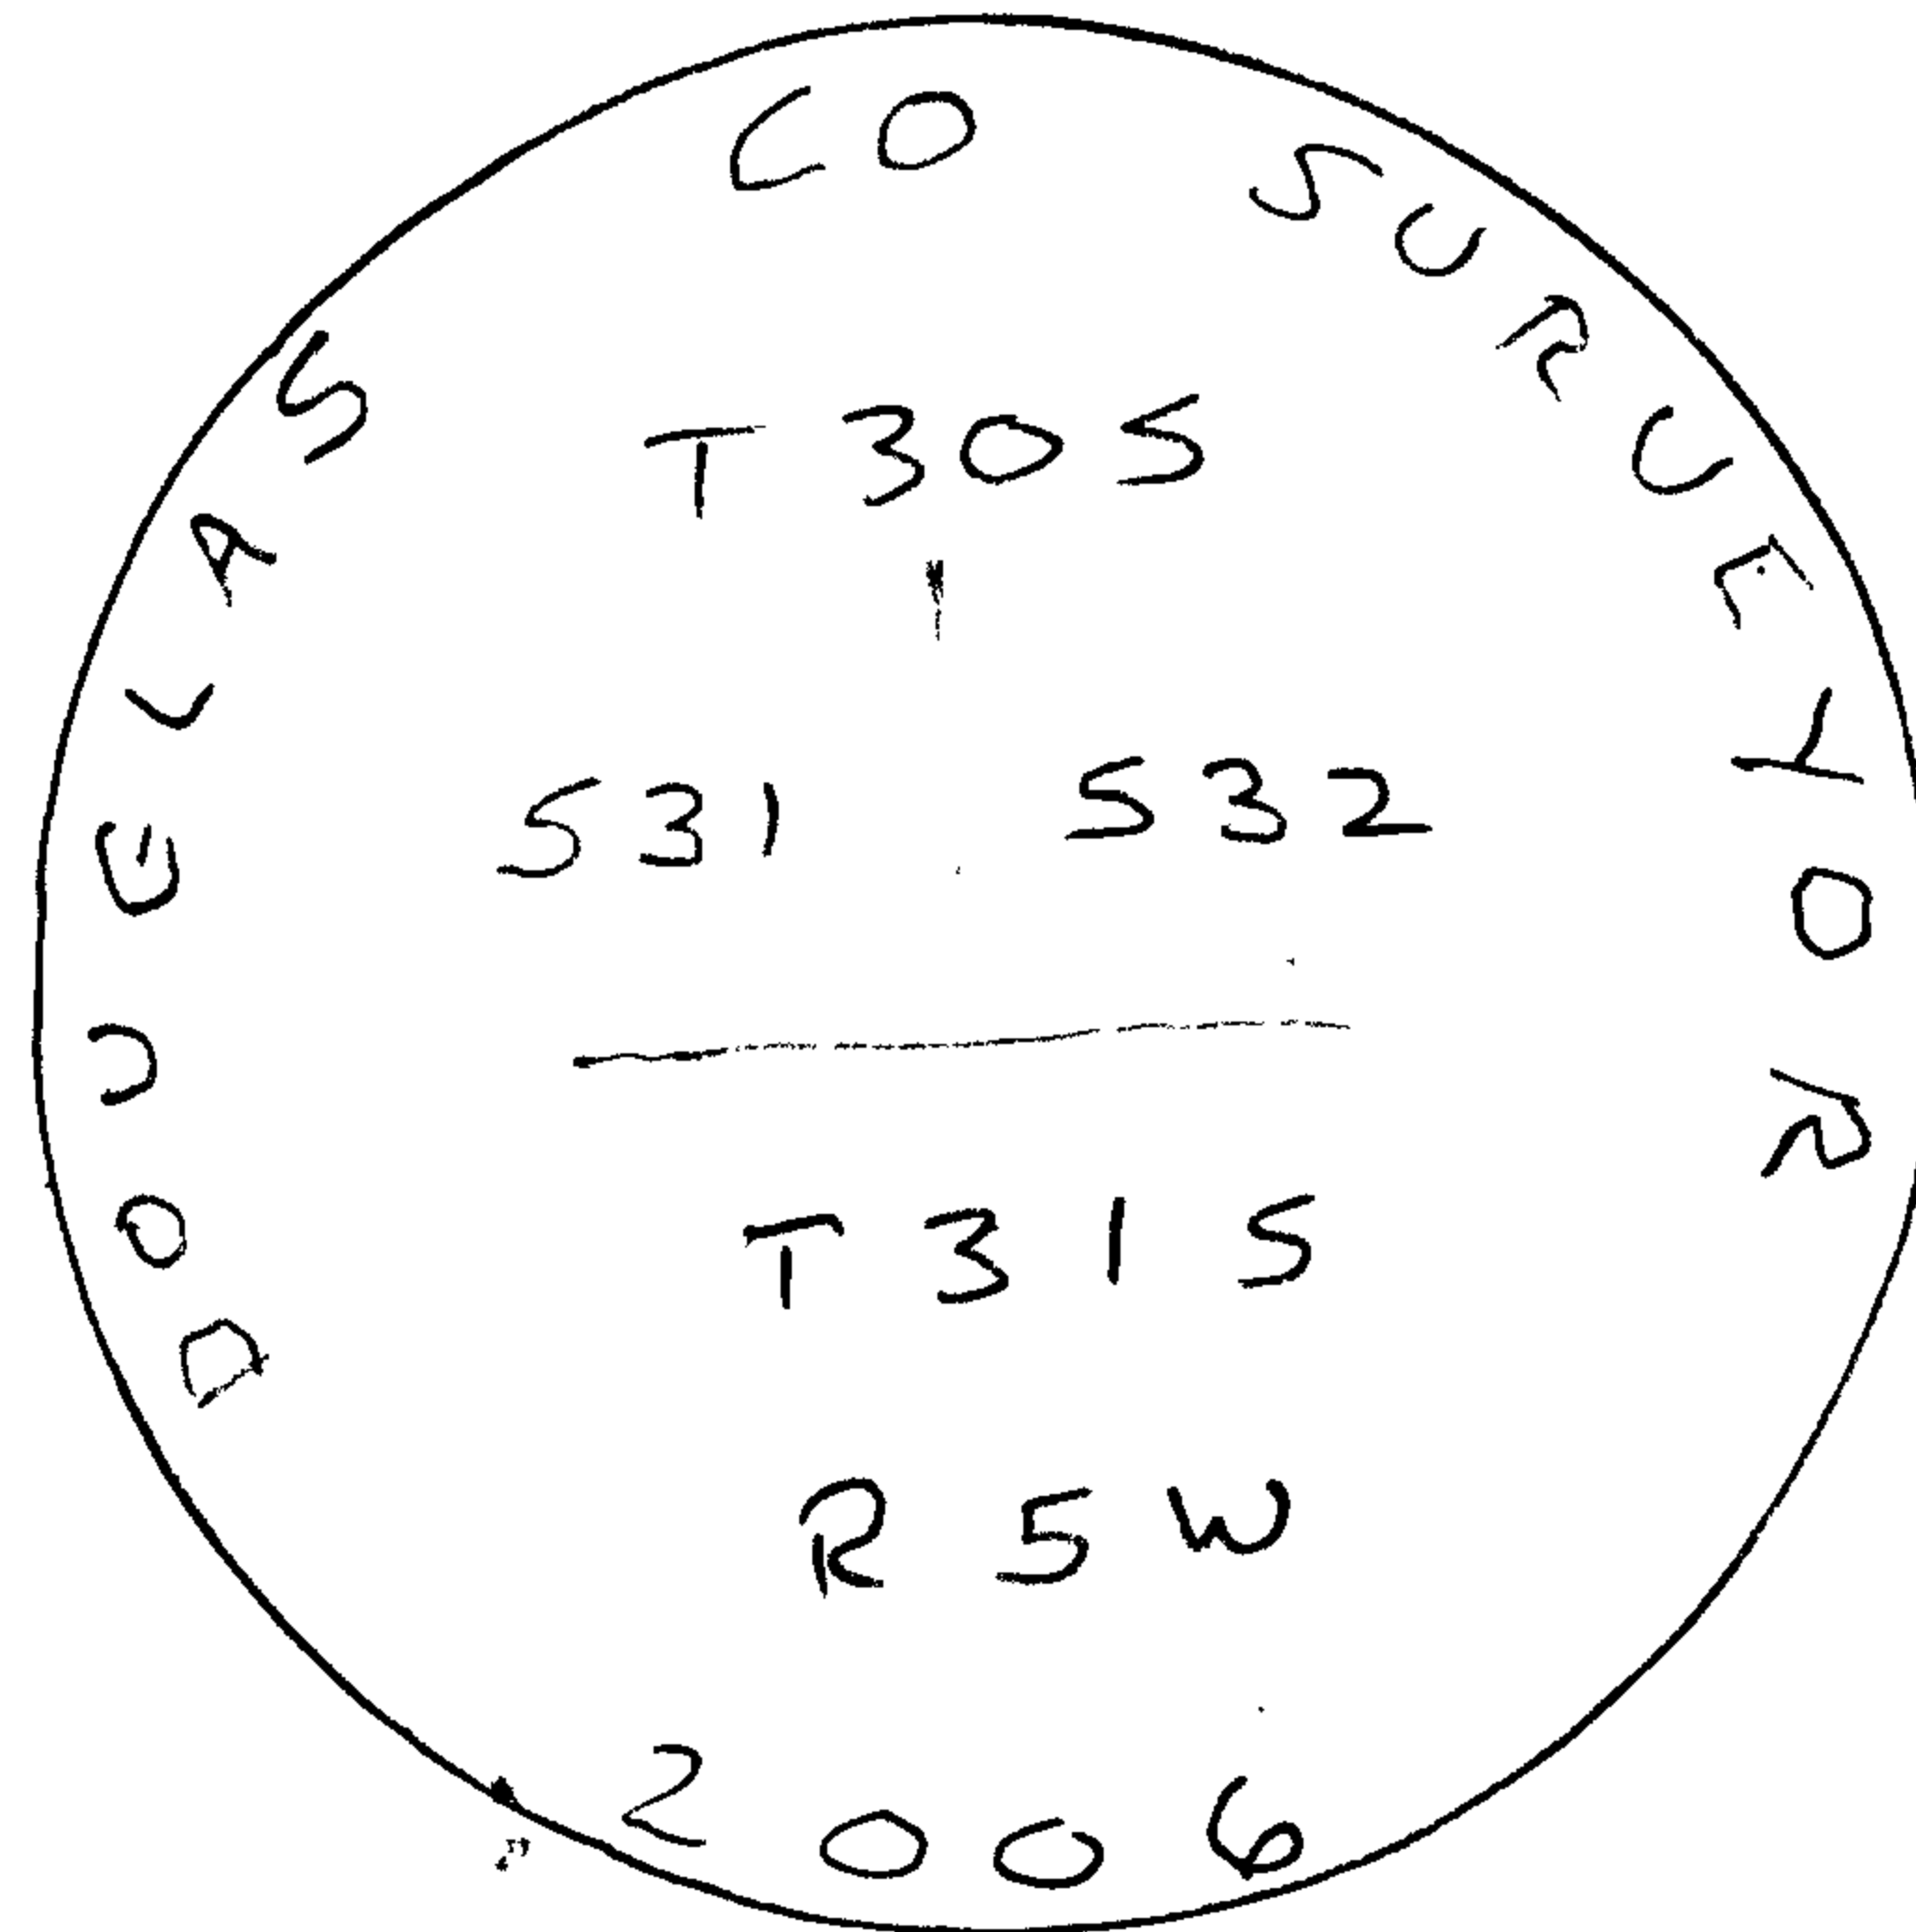

New Accessories

- 8" DIA. CHINGUAPIN, DOUBLE BLAZED & SCRIBED "T305 R5W S31" BEARS N89 1/2° W, 58 FT.
- 7" DIA D.FIR, DOUBLE BLAZED & SCRIBED "T305 R5W S31 CS BT" BEARS N29 1/4° W, 452 FT.
- 7" DIA MADRONE, DOUBLE BLAZED & SCRIBED "T305 R5W S32 CS BT" BEARS N4 1/2° E, 146 FT.
- 9" DIA. D.FIR, DOUBLE BLAZED & SCRIBED "T305 R5W S32 CS BT" BEARS N65 1/2° E, 109 FT.

Sketch of Monument, Accessories, and General Area

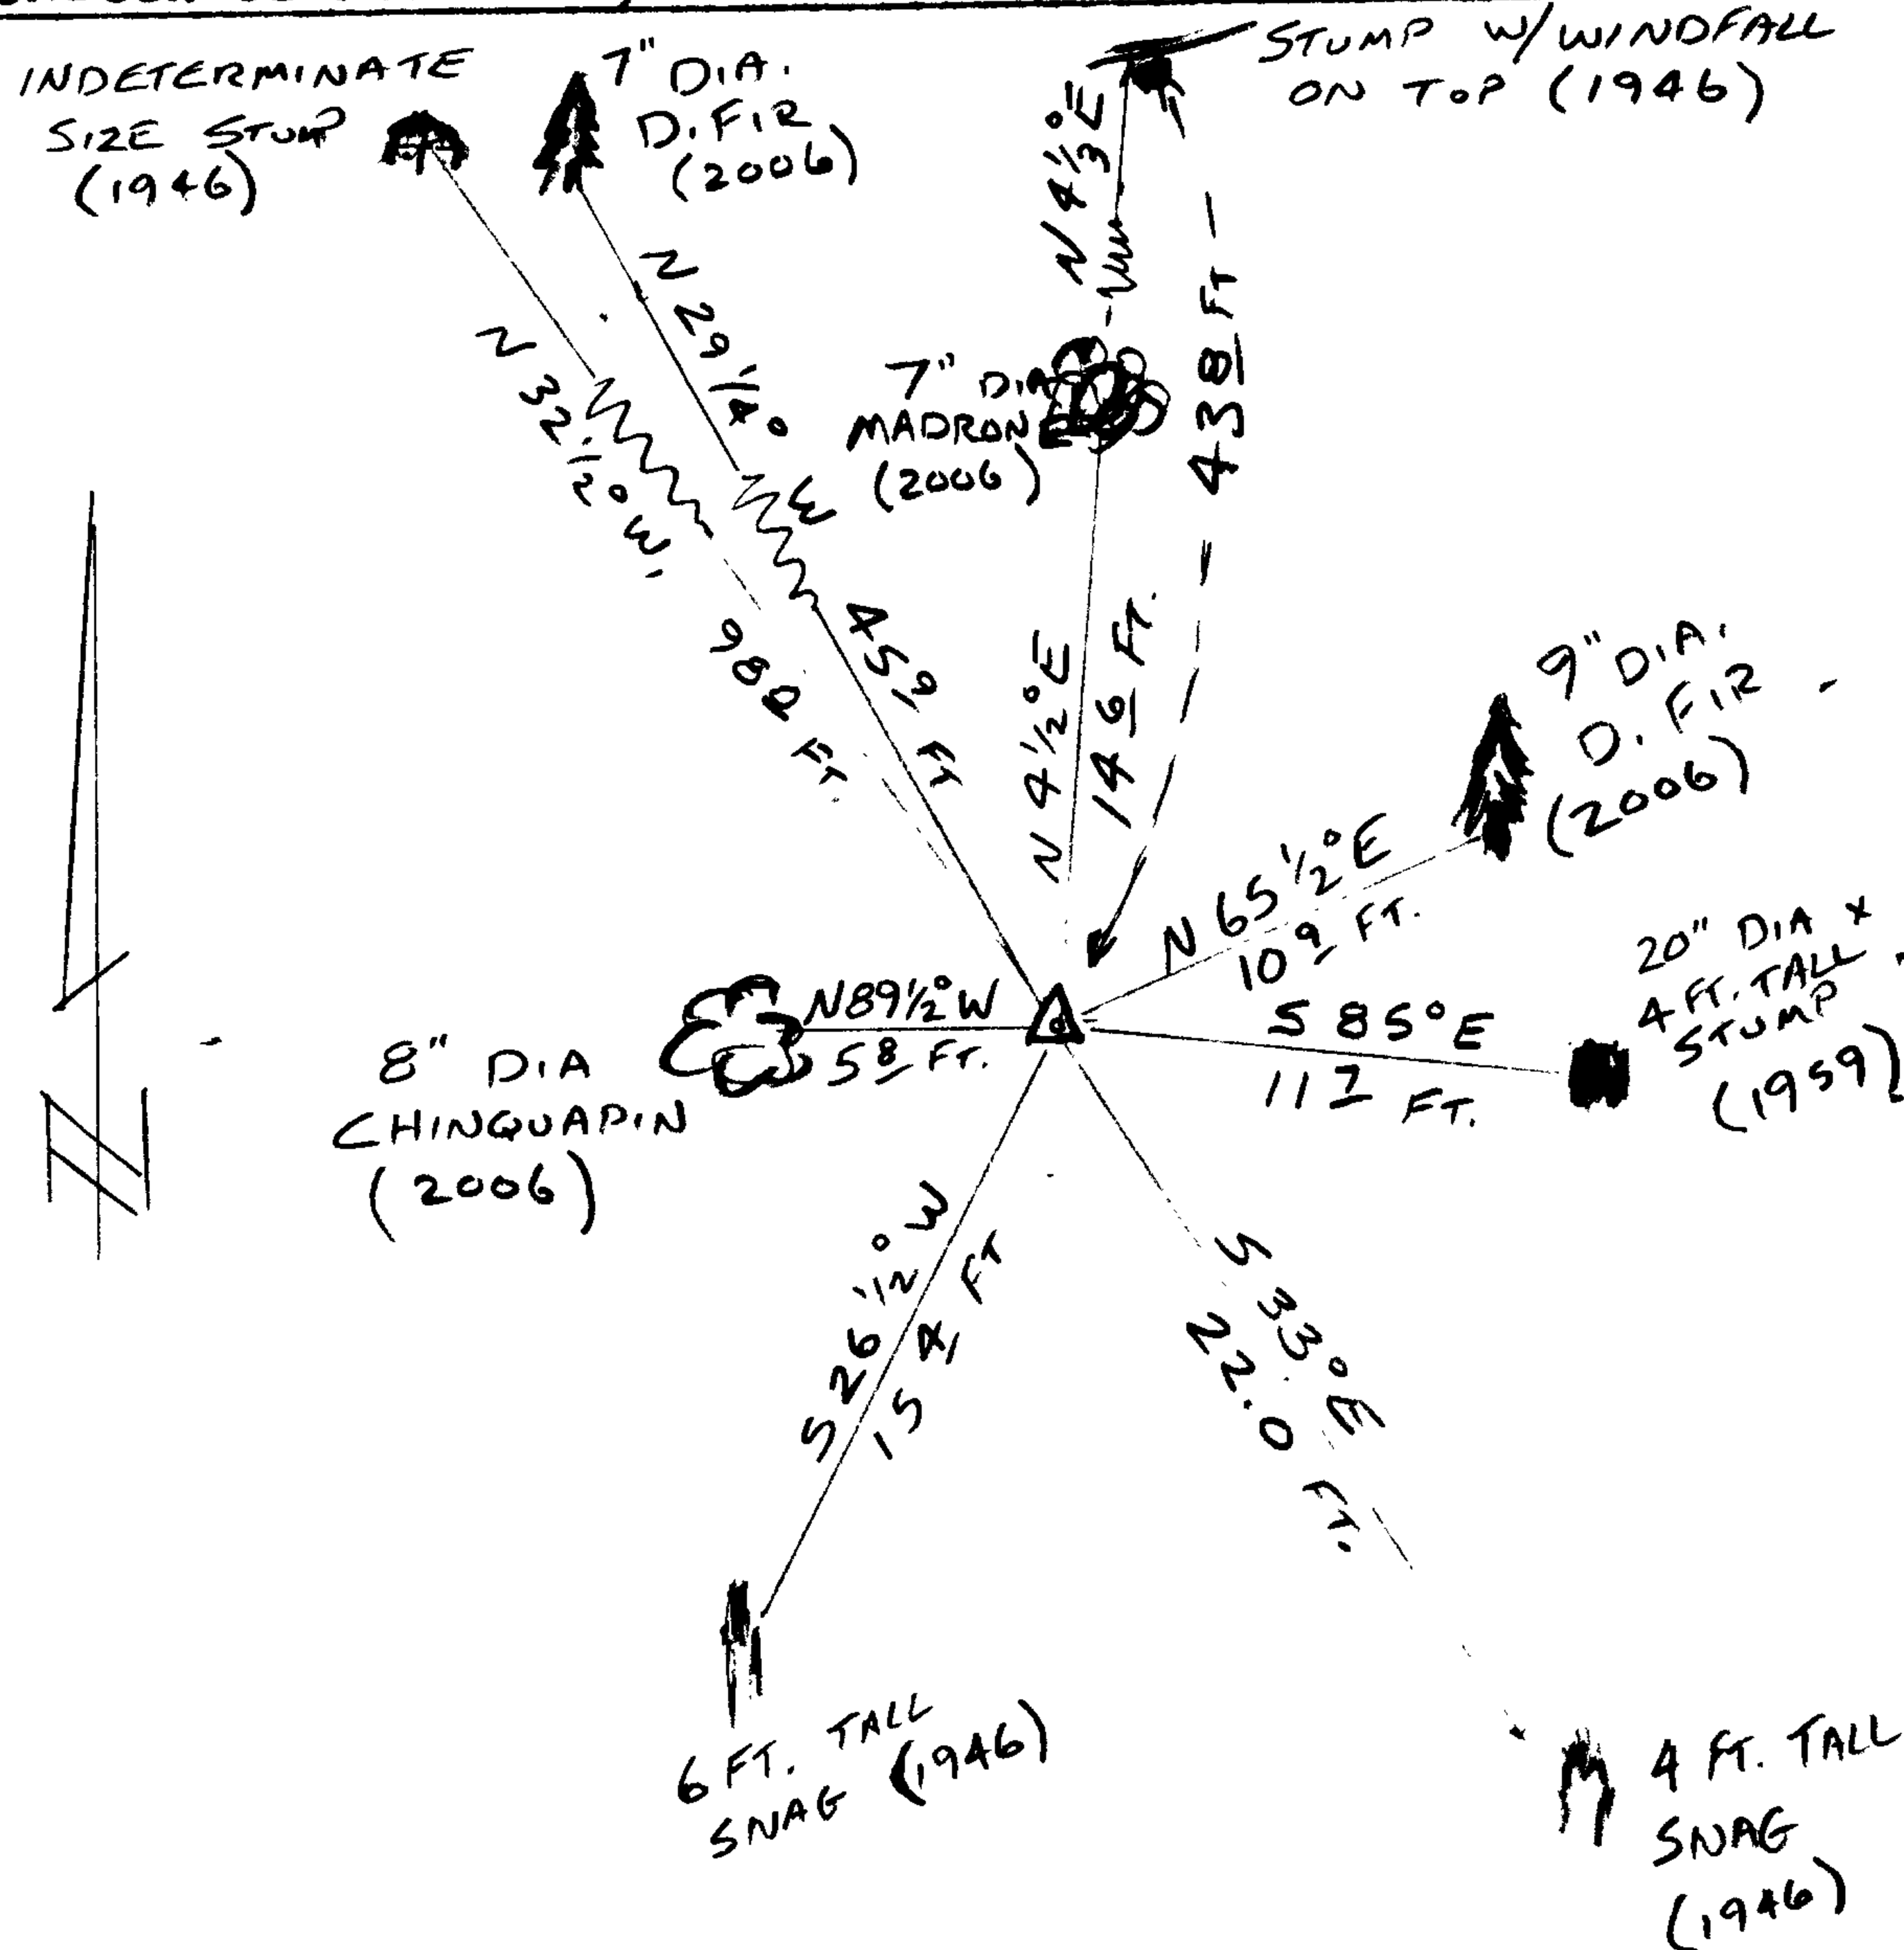

Location & Comments

Comp. Declin. 16 1/2° E
 Agency D.C.S.O.
 Party Chief S. FLAUSE
 Notekeeper J. PIKE
 Witnesses _____

Address _____

Surveyor's Seal

REGISTERED PROFESSIONAL LAND SURVEYOR

Randall W. Smith
 RENEWAL 6-30-09

OREGON
 JULY 25, 1990
 RANDALL W. SMITH
 2489

7/14/09