

FILED

GOVERNMENT CORNER RESTORATION FORM

FILED NOV 16 2006 By: JC

This survey consists of:

Township 31S Range 5W Sec. 4 County DOUGLAS

State OR Date 10-19-06 No. 300600 Name: _____
Corner Post: 67/14-39

Corner Designation

55	54
58	59

DOUGLAS COUNTY SURVEYOR


- Condition Report Only
- Not Found
- Renewed
- Unrecorded
- Surveyed In
- Referenced Out

Previous Renewals 1966

MONUMENT DETAIL

Monument(s) Found: (Condition and Source)

3" DIA. B.L.M.B.C. ON 2 1/2" O.D. I. PIPE
PROJECTS 3" ABOVE GROUND
IN SMALL MOUND OF STONES

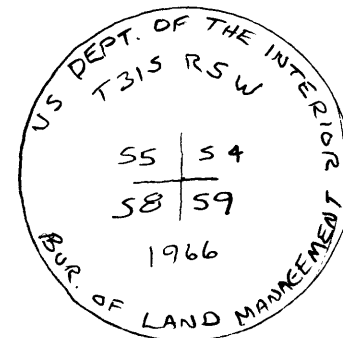

Accessories Found:

12" Now 23" DIA W. FIR HEALED SINGLE BLAZE, BEARS N83°E, 57.8 FT.
(AGREES W/REC)

10" Now 13" DIA. X 1' TALL ROTTEN ^{FL} STUMP PART OF LOW HEALED BLAZE VISIBLE
BEARS S46°W, 17.2 FT. (AGREES W/REC)

17" CEDAR NOT FOUND, FALLS IN ROAD/LANDING

25" Now 30" DIA. X 2' TALL STUMP, EVIDENCE OF HEALED BLAZE VISIBLE
BEARS N59°W, 141.6 FT. (REC N61°W, 139.9 FT)

C.S. File No 67/14-39

