

GOVERNMENT CORNER RESTORATION FORM

FILED NOV 18 2006 FILED By: JC

Township 21 S Range 12 W Sec. 15 County DOUGLAS

Date: 10-25-2006 This survey consists of: Map

State OR Date 10-25-2006 No. 400433

Narrative:
Corner Rpt: 67/14-40

Corner Designation

MEANDER CORNER
FOR SECTIONS
15 & 16

DOUGLAS COUNTY
SURVEYOR


- Condition Report Only
- Not Found
- Renewed
- Unrecorded
- Surveyed In
- Referenced Out

Previous Renewals 1940, 1972

MONUMENT DETAIL

Monument(s) Found: (Condition and Source)

1 3/4" O.D. GALV. IRON PIPE PROJECTS
5" ABOVE GROUND. PIPE HAS A
THREADED CAP ON TOP WITH
MOLTEN BRASS FILED FLAT, STAMPED
"MC 16/15". FOREST SERVICE
WITNESS POST WITH SIGN BEARS
SOUTH, 4 FT.

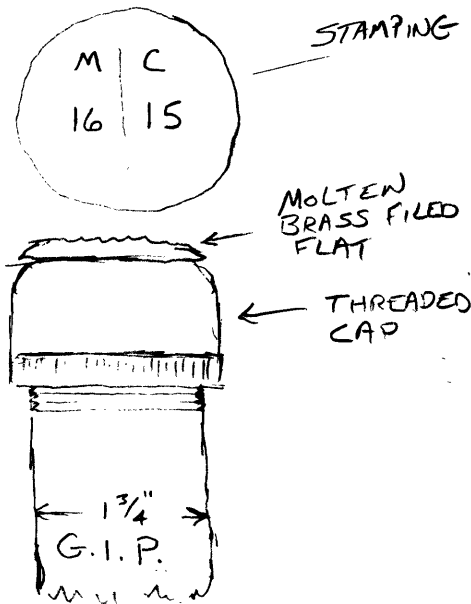

Accessories Found:

54" SPRUCE STOB NOW TIPPED, CRACKED IN HALF, VERY
ROTTED 6 FT. TALL. INDETERMINATE DIA. STOB. ROOT
CROWN POSITION BEARS N 20° W, 100.7 FT. (AGREES W/REG.)

C.S. File No 67/14-40

