

GOVERNMENT CORNER RESTORATION FORM

Date: NOV 27 2006 By: JC

Township 235 Range 5W Sec. 8


County DOUGLAS This survey consists of:
Map: _____

State OR Date 11-14-2006

No. 300540 Narrative: _____

Corner Rpt: 67/14-44

Corner Designation

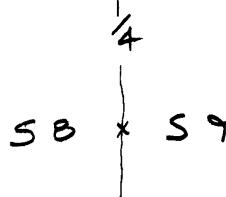

DOUGLAS COUNTY

SURVEYOR

Condition Report Only

Not Found

Renewed

Unrecorded

Surveyed In


Referenced Out

MONUMENT DETAIL

Previous Renewals 1959

Monument(s) Found: (Condition and Source)

2 1/2" B.C. (PROPERLY MARKED)
ON 1 1/4" IRON PIPE, FIRMLY SET
PROJECTS 15' ABOVE GROUND

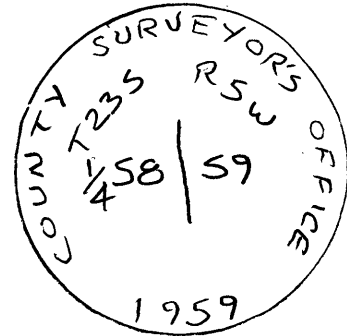

Accessories Found:

20" NOW 20" DIA 2 FT. TALL W. OAK STUMP, ROTTED BLAZE
BEARS N 49°E, 46.8 FT. (AGREES W/REC.) 1959

15" NOW 23" x 1 1/2 FT. TALL D. FIR STUMP END OF HEALED
BLAZE, ROTTED CENTER. BEARS N 68 1/2°E, 49.6 FT.
(AGREES W/REC.) 1959

ORIG 28" NOW FRACTURED REMAINS OF ROTTED B. OAK STUMP
POSITION CHECKS OK (REC. N 46°E, 40.3 FT.) O.B.T.

