

GOVERNMENT CORNER RESTORATION FORM

FILED

Date: 12/19/06 By: J  
This survey consists of:

Township 28 S Range 6 W Sec. 15 County DOUGLAS

State OR Date 12/14/2006 No. 400400

Map:  
Narrative:  
Corner Rpt: 67/14-51

Corner Designation

S 16	S 15
S 21	S 22

DOUGLAS COUNTY SURVEYOR

Condition Report Only

Not Found

Renewed

Unrecorded

Surveyed In


Referenced Out

MONUMENT DETAIL

Previous Renewals 1917, 1954, 1962, 1965

Monument(s) Found: (Condition and Source)

2 1/2" DIA. D.C.S.O. BRASS CAP  
(MARKED AS SHOWN) PROJECTS  
16" ABOVE GROUND FIRMLY SET.  
1/2" I.D. IRON PIPE IS FOUND 12"  
ABOVE GROUND ON EAST EDGE  
OF B.C./I.P.

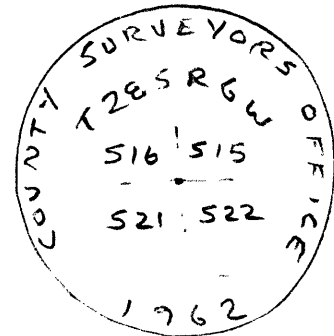

Accessories Found:

- 6" B. OAK Now 12" W. OAK HEALED BLAZE  
VISIBLE; BEARS N10°12' W, 4.6 FT.  
(ACREES W/REC.) 1965 B.T.

- NO TRACE OF ANY OTHER ACCESSORY OF RECORD FOUND.

C.S. File No 67/14-51

