

GPS C120711A

FILED JAN 3 2007

DEC. 7, 2006

T. 23 S R S W 600240

$\frac{1}{4}$  S 26  $\circ$  S 25

FOUND  $\frac{5}{8}$ " I.R. W/ALUM  
CAP & 4 UNMARKED BT'S  
W/TAGS AS PER M137-55

T. 23 S R S W 340300

$\frac{1}{4}$   $\frac{S 21}{S 28}$

FOUND BLM BC ON SS POST  
ALSO BAUGHMAN'S ERRONEOUS BC.  
#  $\frac{5}{8}$ " I.R. AS ACCESSORIES.  
BAUGHMAN'S  $\frac{5}{8}$ " I.R. WITNESS COR.  
BEARS  $S 3^{\circ} E$ , 5.9 FT. FROM ERRONEOUS  
B.C. (AS PER B.L.M. REC.)

T 23 S R S W 300300

$\frac{S 20}{S 29}$  |  $\frac{S 21}{S 28}$

FOUND OK, 4 LIVE BT'S  
AS PER BLM 1997 RENEWAL


C.S. File No 67/14-53

T. 23 S R S W - 047040


WNW COR. D.C. # 47

FD. AS PER 1984 D.C.S.O.  
RENEWAL

D. C. S. O.  
JOHN PIKE  
STEVE FLAUSE

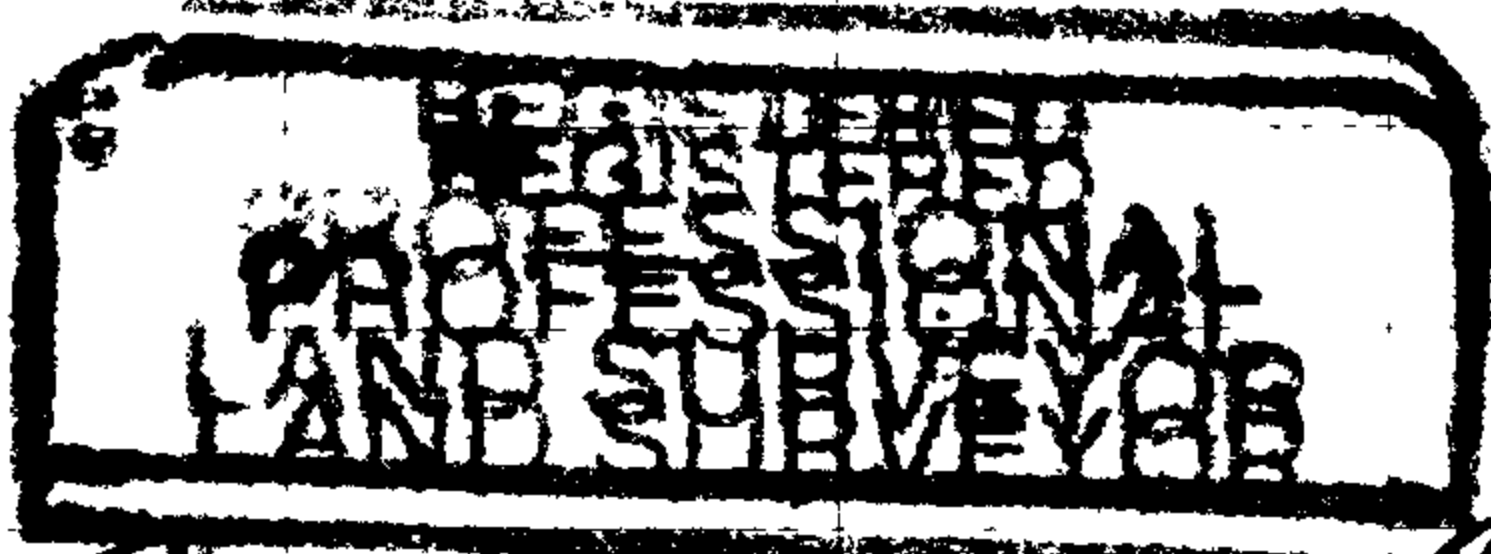

*Handwritten signature*

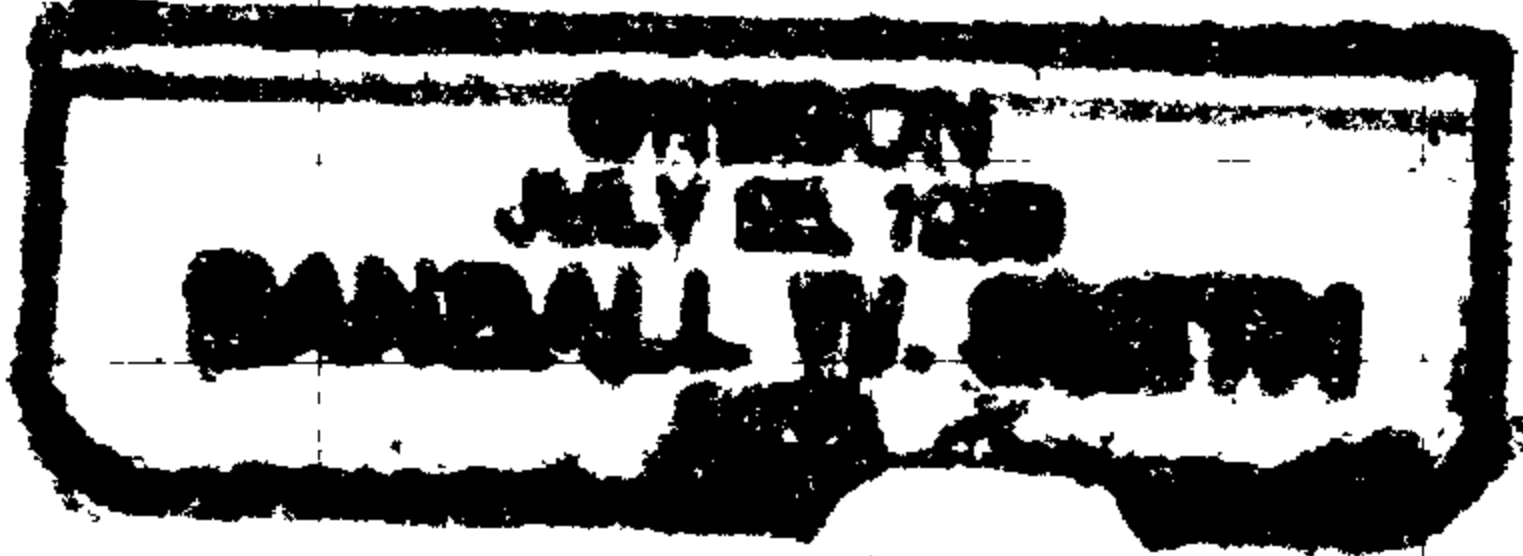

*LOWWAC - 6-30-09*