

FILED MAR 5 2007

FEB. 28, 2007


T. 27 S R5W 440400

$\frac{1}{4} \frac{S15}{S22}$

NOT FOUND

THREE OAK TREES WERE CUT INTO IN THE VICINITY OF $\frac{1}{4}$ COR POSITION. AFTER COUNTING GROWTH RINGS OF THESE SAMPLES, IT WAS DETERMINED THERE ARE NO TREES IN THIS AREA OLD ENOUGH TO BE ORIGINAL BEARING TREES.

DOUGLAS COUNTY SURVEYOR'S OFFICE.

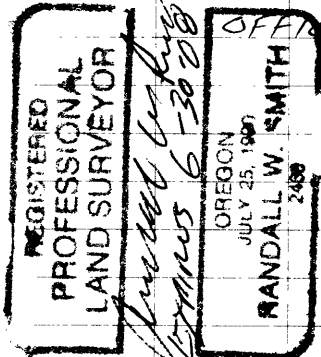

JOHN PIKE
STEVE FLAUSE

C.S. File No 67/21-12