


RENEWAL

Monument Detail

Monument Set (Procedure and Description)


- 2 1/2" DIA. BRASS CAP (MARKED AS SHOWN) ON 1/4" O.D. X 30" LONG IRON PIPE PROJECTS 8" ABOVE GROUND.
- 1979 BRASS CAP IS CUT OFF. REMAINING 1/4" O.D. IRON PIPE PROJECTS 6" ABOVE GROUND AND NOW BECOMES AN ACCESSORY TO NEW POSITION.
- BEARING TREE TAGS ARE REMOVED FROM TREES WITNESSING THE 1979 POSITION.

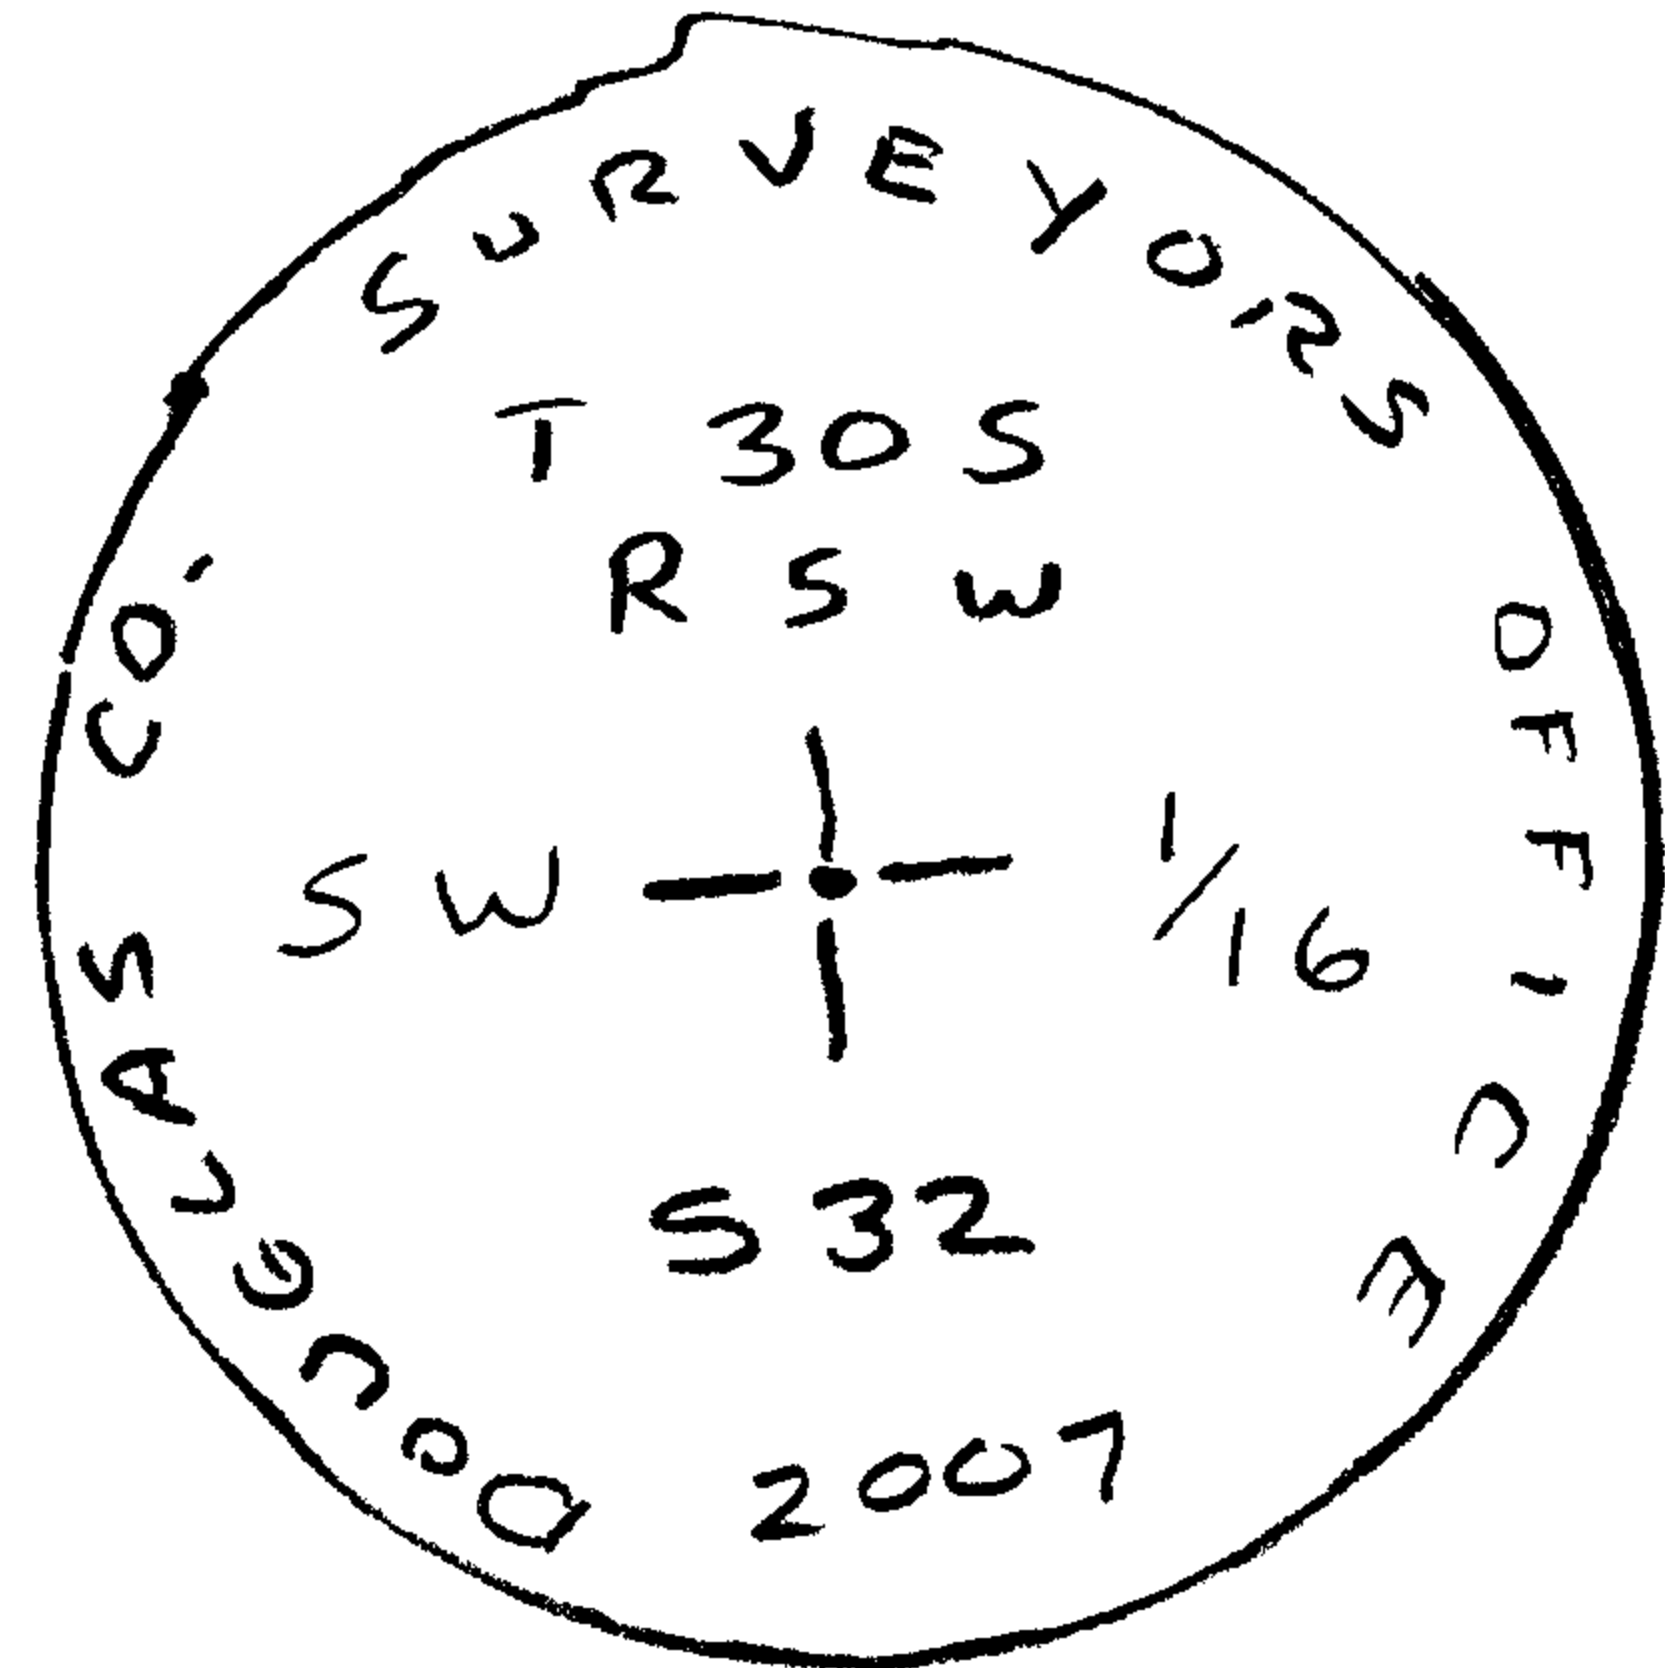

New Accessories

- 8" DIA. D. FIR, DOUBLE BLAZED & SCRIBED "SW 1/16 S32 CS BT" BEARS S 74° W, 15.3 FT.
- 10" DIA. MADRONE, DOUBLE BLAZED & SCRIBED "SW 1/16 S32 CS BT" BEARS N 2 1/2° E, 15.7 FT.
- 1/4" O.D. IRON PIPE, FLUSH W/GROUND, BEARS N 75° 39' 50" W, 217.32 FT. (1979 BC POSITION)

Sketch of Monument, Accessories, and General Area

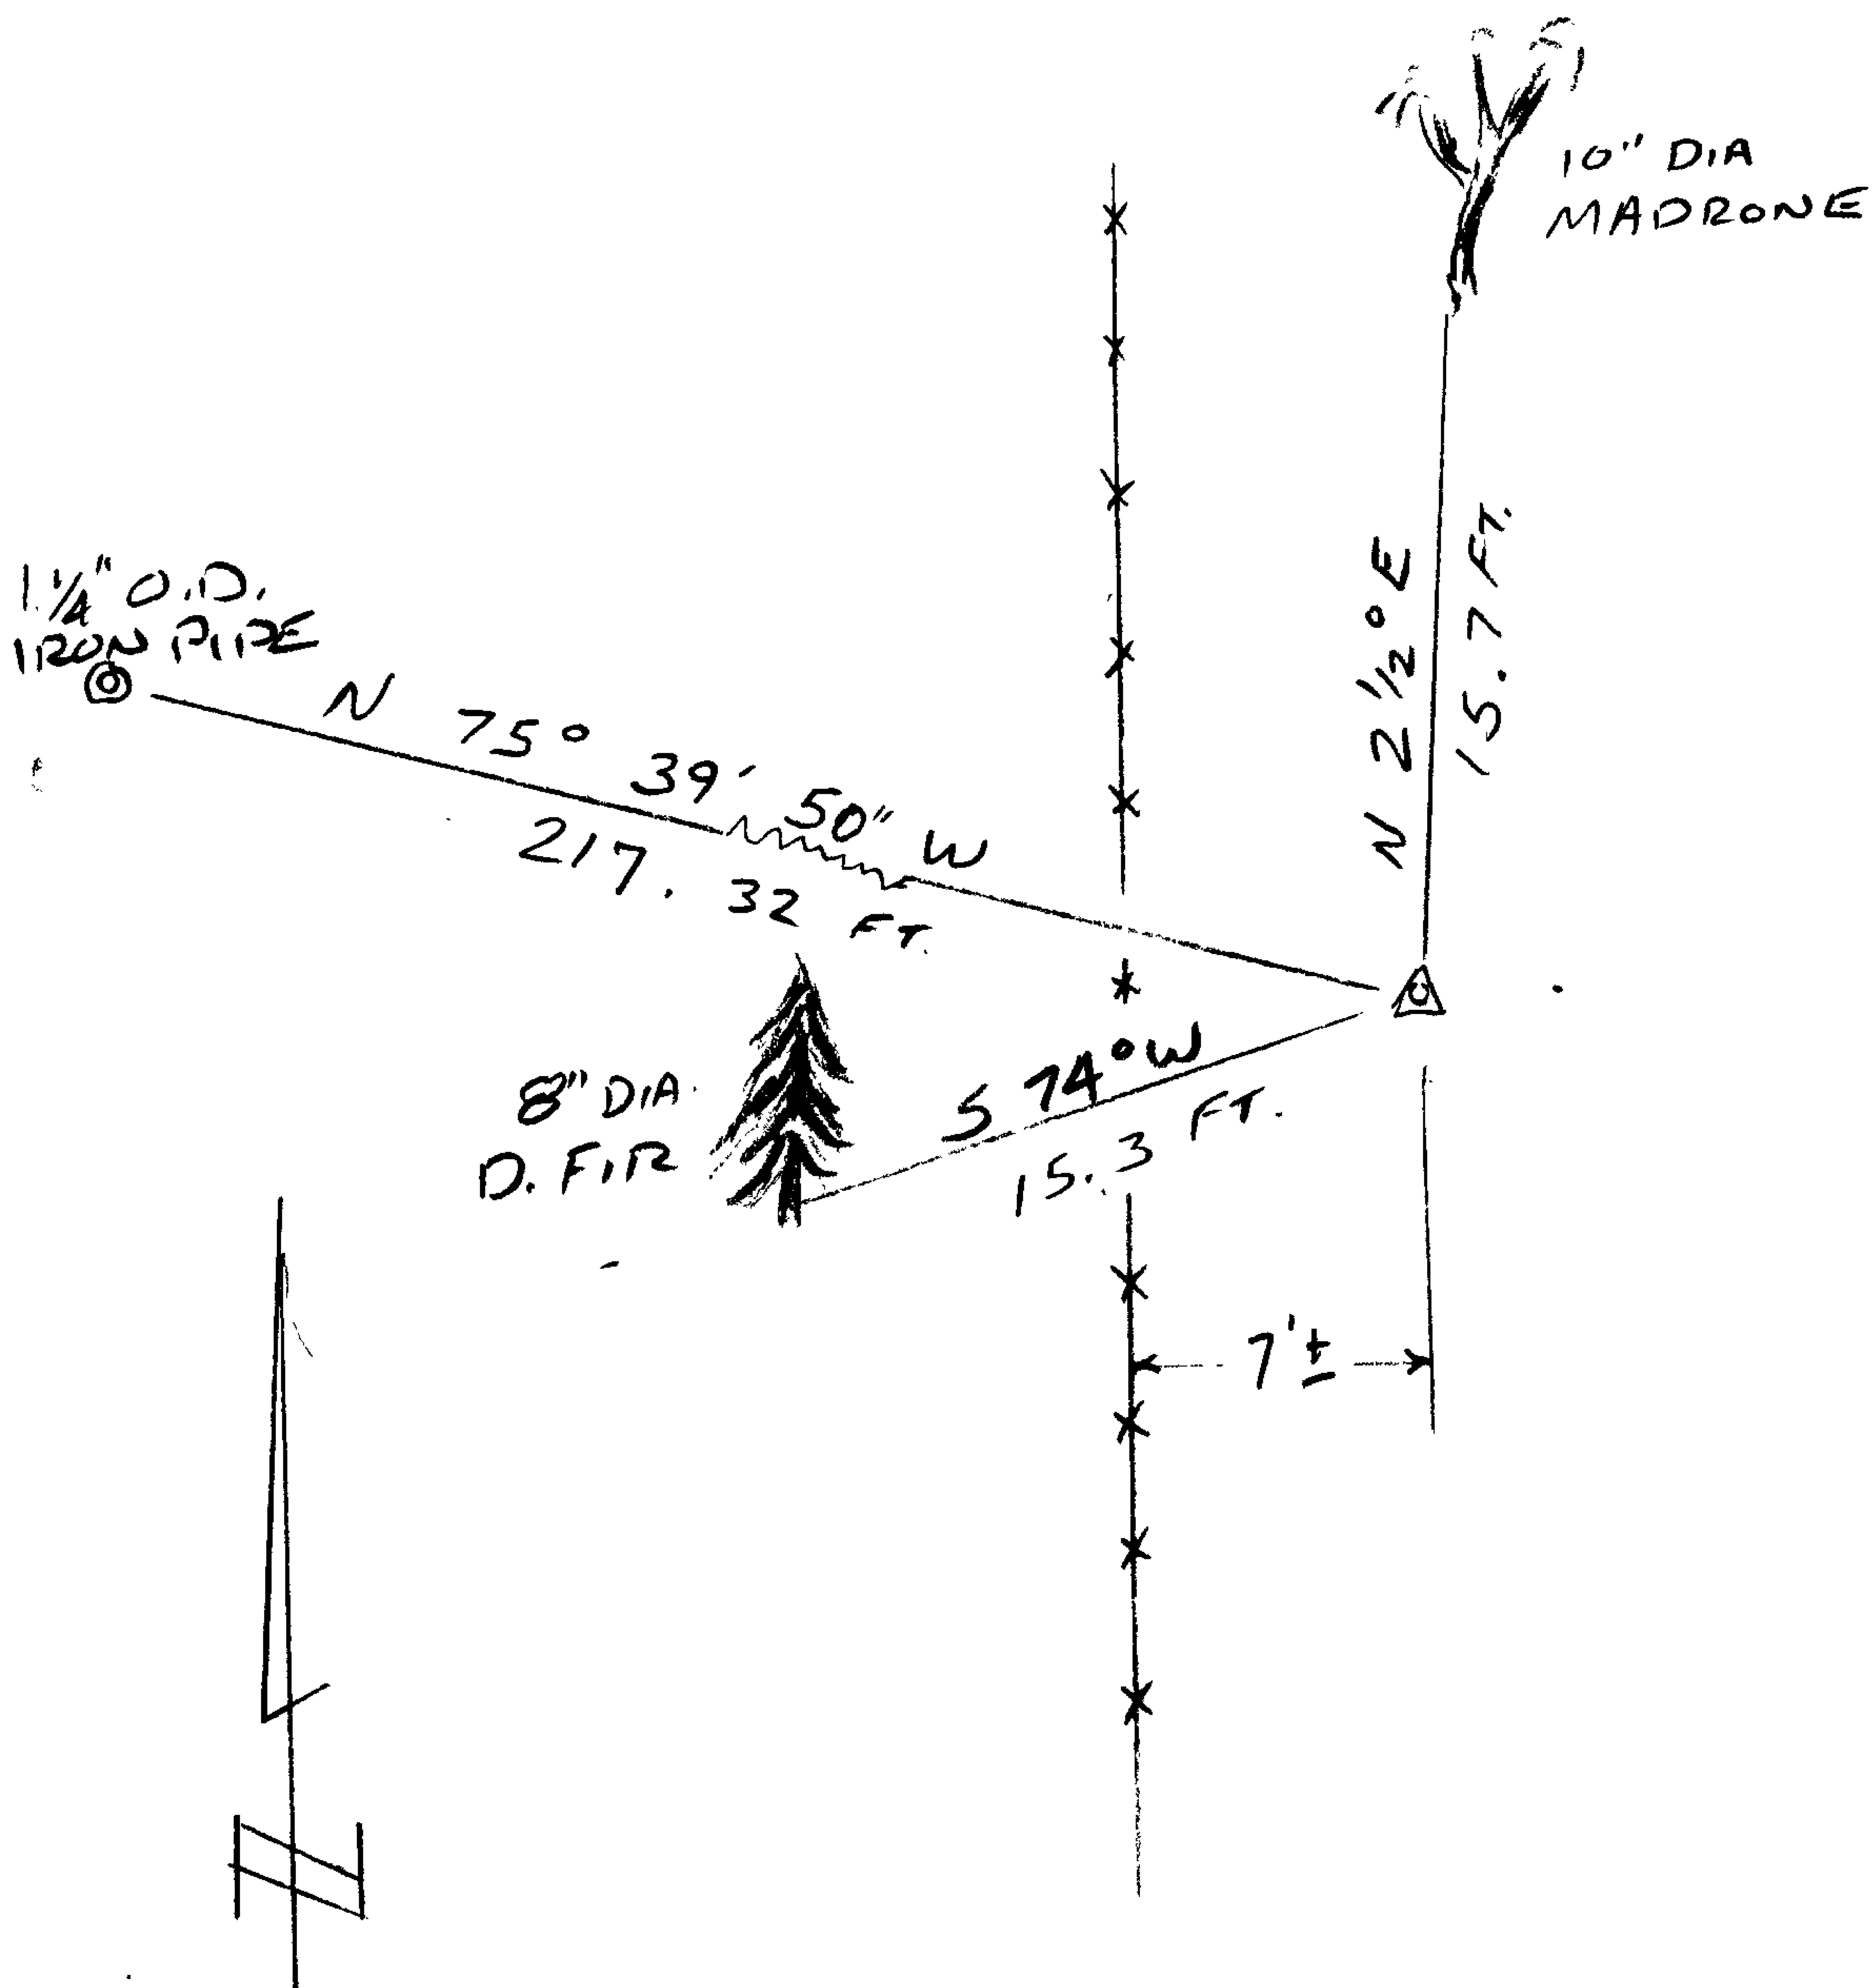

Location & Comments

CORNER LIES ON STEEP NORTHWESTERLY FACING SLOPE APPROX. 7 FT. EAST OF DILAPIDATED N-S FENCE LINE.

Comp. Declin. 16 1/4° E
 Agency D.C.S.O.
 Party Chief S. FLAUSE
 Notekeeper J. PIKE
 Witnesses

Address

Surveyor's Seal

REGISTERED PROFESSIONAL LAND SURVEYOR

Handwritten signature and date: Expires 6-30-08

OREGON
 JULY 25, 1990
 RANDALL W. SMITH
 2469