

GOVERNMENT CORNER RESTORATION FORM

FILED

Date: 4/6/2007 By: [Signature]

Township 22S Range 13W Sec. 13 County DOUGLAS

This survey consists of:

State OR Date 2/19/2007

No. 600440

Map: _____

Narrative: _____

Corner Rpt: 67/21-20

Corner Designation

1/4 COR SECTIONS 14 & 13

DOUGLAS COUNTY SURVEYOR


- Condition Report Only
- Not Found
- Renewed
- Unrecorded
- Surveyed In
- Referenced Out

Previous Renewals 1977, 1982, 1988

Monument(s) Found: (Condition and Source)

1983 BLM 3/4" DIA BRASS CAP ON 2 1/4" I.P. PROJECTING 6" ABOVE GROUND.

MONUMENT DETAIL

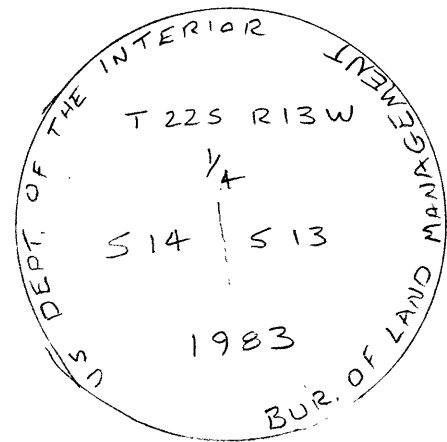

Accessories Found:


5" Now 9" SPRUCE, FULLY HEALED DOUBLE BLAZE, BEARS N55 1/2°W, 32.6 FT. (AGREES W/REC.) 1988 BT

6" Now 9" SPRUCE, FULLY HEALED DOUBLE BLAZE, BEARS S10°E, 12.0 FT. (AGREES W/REC.) 1988 BT

STEEL POST W/WHITE PADDLE SIGN BEARS S 49°E, 1.7 FT. AGREES W/REC.

NO OTHER ACCESSORIES LOOKED FOR

C.S. File No 67/21-20

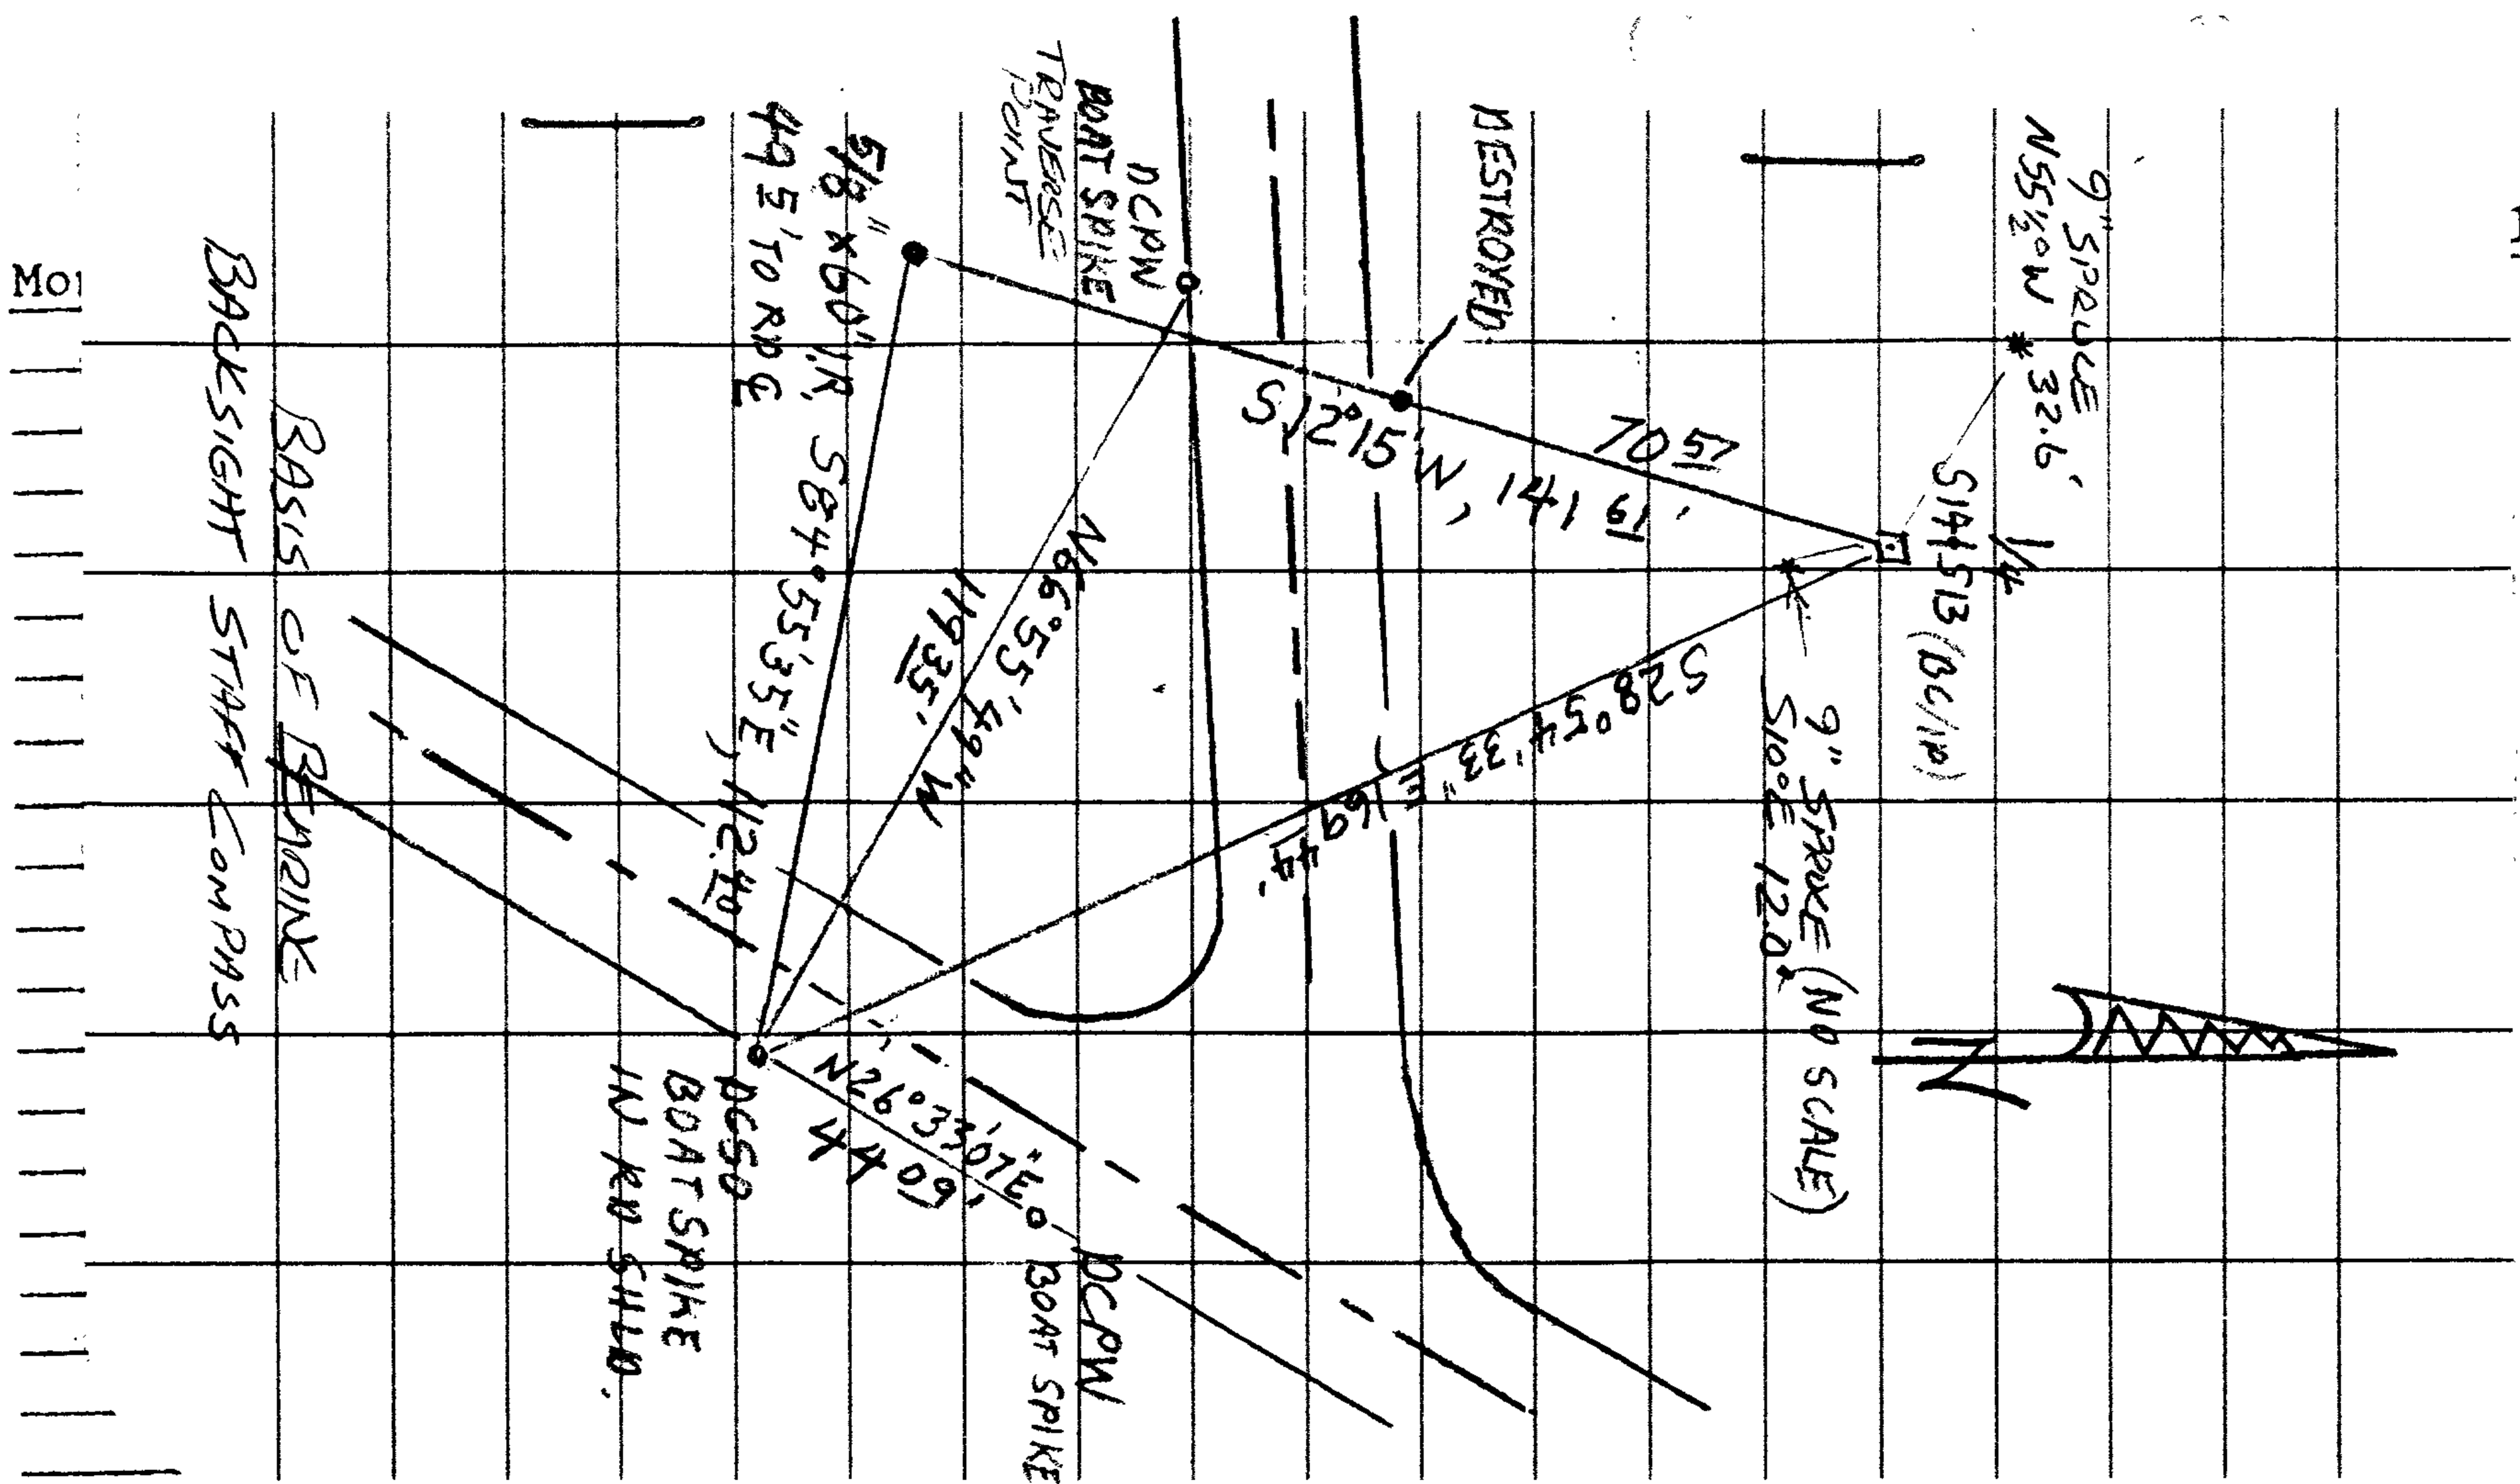

New Accessories

- 5/8" DIA. X 60" LONG IRON ROD, NO CAP, BEARS S 12° 15' W, 141.61 FT.
 - BOAT SPIKE IN EDGE OF ROAD, DRIVEN FLUSH, BEARS S 28° 59' 33" E, 169.44 FT.
- BASIS OF BEARING BACKSIGHT STAFF COMPASS, SEE SKETCH OF REFERENCED CORNER IN FILE.

Sketch of Monument, Accessories, and General Area

Location & Comments

LOCATED NORTHWESTERLY OF INTERSECTION OF SALMON HARBOR DR. & BEACH ACCESS RD.
 NOTE: ADDITIONAL ACCESSORIES WERE ADDED BECAUSE CORNER WAS IN DANGER OF BEING DESTROYED DUE TO CONSTRUCTION OF NEW CAMPGROUND TO THE NORTH.

Comp. Declin. 16 1/4° E

Agency D.C.S.O.

Party Chief S. FLAUSE

Notekeeper J. PIKE

Witnesses _____

Address _____

Surveyor's Seal
REGISTERED PROFESSIONAL LAND SURVEYOR

Randall W. Smith
 EXPIRES 6-30-09

OREGON
 JULY 25, 1990
RANDALL W. SMITH
 2488

CS
 67/21-20B