

GOVERNMENT CORNER RESTORATION FORM

FILED

Date: 5/1/2007 By: JL
This survey consists of:

Township 25S Range 7W Sec. 26 County DOUGLAS

State OREGON Date 4-17-2007 No. 048010

Mag: _____
Narrative: _____
Corner Rpt: 67/21-27

Corner Designation

NE COR. D.L.C. 48

DOUGLAS COUNTY
SURVEYOR

Condition Report Only

Not Found

Renewed

Unrecorded

Surveyed In


Referenced Out

MONUMENT DETAIL

Previous Renewals

Monument(s) Found: (Condition and Source)

SANDSTONE, PROJECTS 6"
ABOVE GROUND, FIRMLY SET. TOP
MEASURES APPROX. 5" X 5". "X"
IS CLEARLY VISIBLE ON TOP.
- NO RECORD -

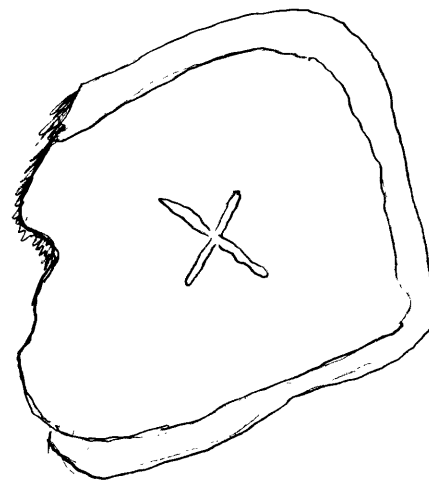

Accessories Found:

CREEK BEARS WEST APPROX. 270 FT. TO CENTER (THREAD)
(REC. 250' FT.)

ORIG. B.T. NOT FOUND

C.S. File No 67/21-27

