

GOVERNMENT CORNER RESTORATION FORM

FILED MAY 22 2007

Township 30S Range 8W Sec. 18 County DOUGLAS

FILED

State OR Date 4/24/07 No. 140400

Date: 5/22/07 By: K

This survey consists of:

Corner Designation

Map: _____

Name: 67/21-31

Condition Report Only

Not Found

Renewed **DOUGLAS COUNTY**

Unrecorded **SURVEYOR**

Surveyed In

Referenced Out


MONUMENT DETAIL

Previous Renewals REN # 69 1965

Monument(s) Found: (Condition and Source)

- 44" DIA CEDAR CORNER TREE NOW
46" DIA X 2 FT. TALL HOLLOWED
OUT STUMP

- 2 1/2" DIA BRASS CAP (PROPERLY MKD)
ON 1 1/4" O.D. IRON PIPE, PROJECTS
12" ABOVE GROUND. AND BEARS
EAST 10.0 FROM CENTER OF
CORNER TREE STUMP. FIRMLY SET.

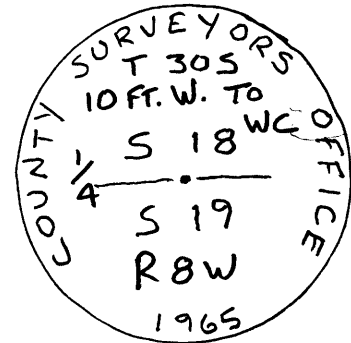

Accessories Found:

11" NOW 12" DIA X 6" TALL VERY ROTTED HEMLOCK STUMP
BEARS S 5° E, 19.8 FT. (AGREES W/REC.; 1965 BT
REFERENCING WITNESS CORNER)

8" HEMLOCK NOW GONE 1965 BT

46" NOW 46" DIA X 3 FT. TALL ROTTED FIR STUMP, BARK GONE
FROM FACE SHOWS BURLED WOOD, BEARS N 19° W, 30.4 FT.
CENTER TO CENTER. WE MEAS. 28.4 FT. FROM EDGE OF
CORNER TREE TO CENTER OF BT. FROM FACE TO FACE WE
MEAS. 27.0 FT. (REC N 26° W, 28.4 FT.)

27" CEDAR (O.B.T.) NOW DOWN AND ROTTED, BARK GONE, NO
MARKS VISIBLE. ROOT HOLE AGREES OR W/REC. (S 40° E, 17.8")

C.S. File No 67/21-31

