

GOVERNMENT CORNER RESTORATION FORM

FILED MAY 31 2007

Township 285 Range 6W Sec. 34 County DOUGLAS

45.1

State OR Date MAY 9, 2007 No. 042010

49 C N 36 1/4 E

Corner Designation

E. NE COR PHIPPS DLC 42


- Condition Report Only
- Not Found
- Renewed
- Unrecorded
- Surveyed In
- Referenced Out

Previous Renewals 1921

MONUMENT DETAIL

Monument(s) Found: (Condition and Source)

AXLE (PITMAN) TAPERED AT TOP WITH
KEYWAY EVIDENT. TOP OF AXLE
IS MUSHROOMED AND MEASURES
APPROX. 1 1/4". PROJECTS 5"
ABOVE GROUND. FIRMLY SET. NO
PILE OF STONES FOUND

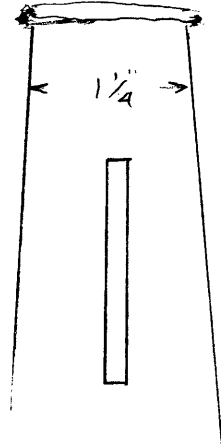

Accessories Found:

10" NOW 28' DIA. W. OAK, HEALED SINGLE BLAZE VISIBLE
BEARS S 81° W, 64.2 FT AGREES W/REC. 1921 BT

12" W. OAK NOW GONE (REC. N 18° E, 129.3 FT)

