

GOVERNMENT CORNER RESTORATION FORM

FILED MAY 22 2007  
FILED

Township 21 S Range 5 W Sec. 34 County DOUGLAS

Date: 5/22/2007 By SC  
This survey consists of:

State OR Date 5-10-2007 No. 509100

Map: \_\_\_\_\_  
Name: \_\_\_\_\_  
Corner No: 67/21-36

Corner Designation

SE COR SEC. 34


- Condition Report ONLY
- Not Found SURVEYOR
- Renewed
- Unrecorded
- Surveyed In
- Referenced Out

Previous Renewals 1953, 1965

MONUMENT DETAIL

Monument(s) Found: (Condition and Source)

2 1/2" DIA BRASS CAP ON 1/4" O.D. IRON  
PIPE PROJECTS 5" ABOVE GROUND  
NOTE: DATE WAS NOT STAMPED ON  
BC.

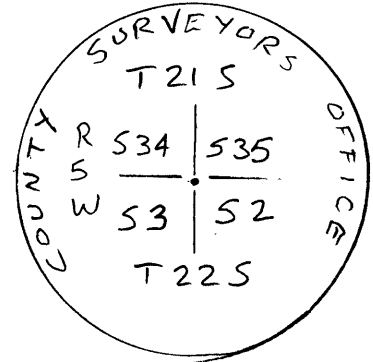

Accessories Found:

- ORIG 30" NOW INDETERMINATE DIA. ROTTING, D. FIR <sup>STUMP</sup>, APPROX 5 FT TALL  
ORIG SCRIBING INTACT. BEARS S33°E 17.2 FT.  
(AGREES W/RECORD) O.B.T.
- 19" NOW 20" DIA X 3 FT. TALL ROTTING D. FIR STUMP, HEALED LOW BLAZE  
BEARS N21°E, 31.3 FT. (AGREES W/REC.)
- 28" NOW BLOWN DOWN AND CUT OFF FIR STUMP - NO POSITION (REC N21°W, 9.0 FT)
- 46" NOW 57" X 4 FT TALL D. FIR STUMP, TOP CUT AT ANGLE, AND  
CAPPED WITH CALV. ROOFING HEALED BLAZE VISIBLE, ~~BE~~  
BEARS S22°W (NO DIST MEAS. DUE TO THICK UNDERBRUSH, BEARING  
WAS NOTED BY POINTING COMPASS AT L.E.D.)

RENEWAL

Monument Set (Procedure and Description)


Monument Detail

STAMPED DATE "1965" ONTO BRASS CAP

New Accessories

- DOUBLE TRUNK HEMLOCK, WESTERLY TRUNK IS 8" DIA AND SCRIBED "T22SR5W52CSBT"  
BEARS S 35° E, 16.2 FT. TREE IS GROWING ON SIDE OF O.B.T. STUMP
- 4" DIA. D. FIR, DOUBLE BLAZED & SCRIBED "XCS" ON HIGH BLAZE & "BT" ON LOW BLAZE  
BEARS S 42 3/4° W, 15.4 FT.
- 5" DIA. G. FIR, DOUBLE BLAZED & SCRIBED "XCS" ON HIGH BLAZE & "BT" ON LOW BLAZE  
BEARS N 51° W, 42.9 FT.

Sketch of Monument, Accessories, and General Area

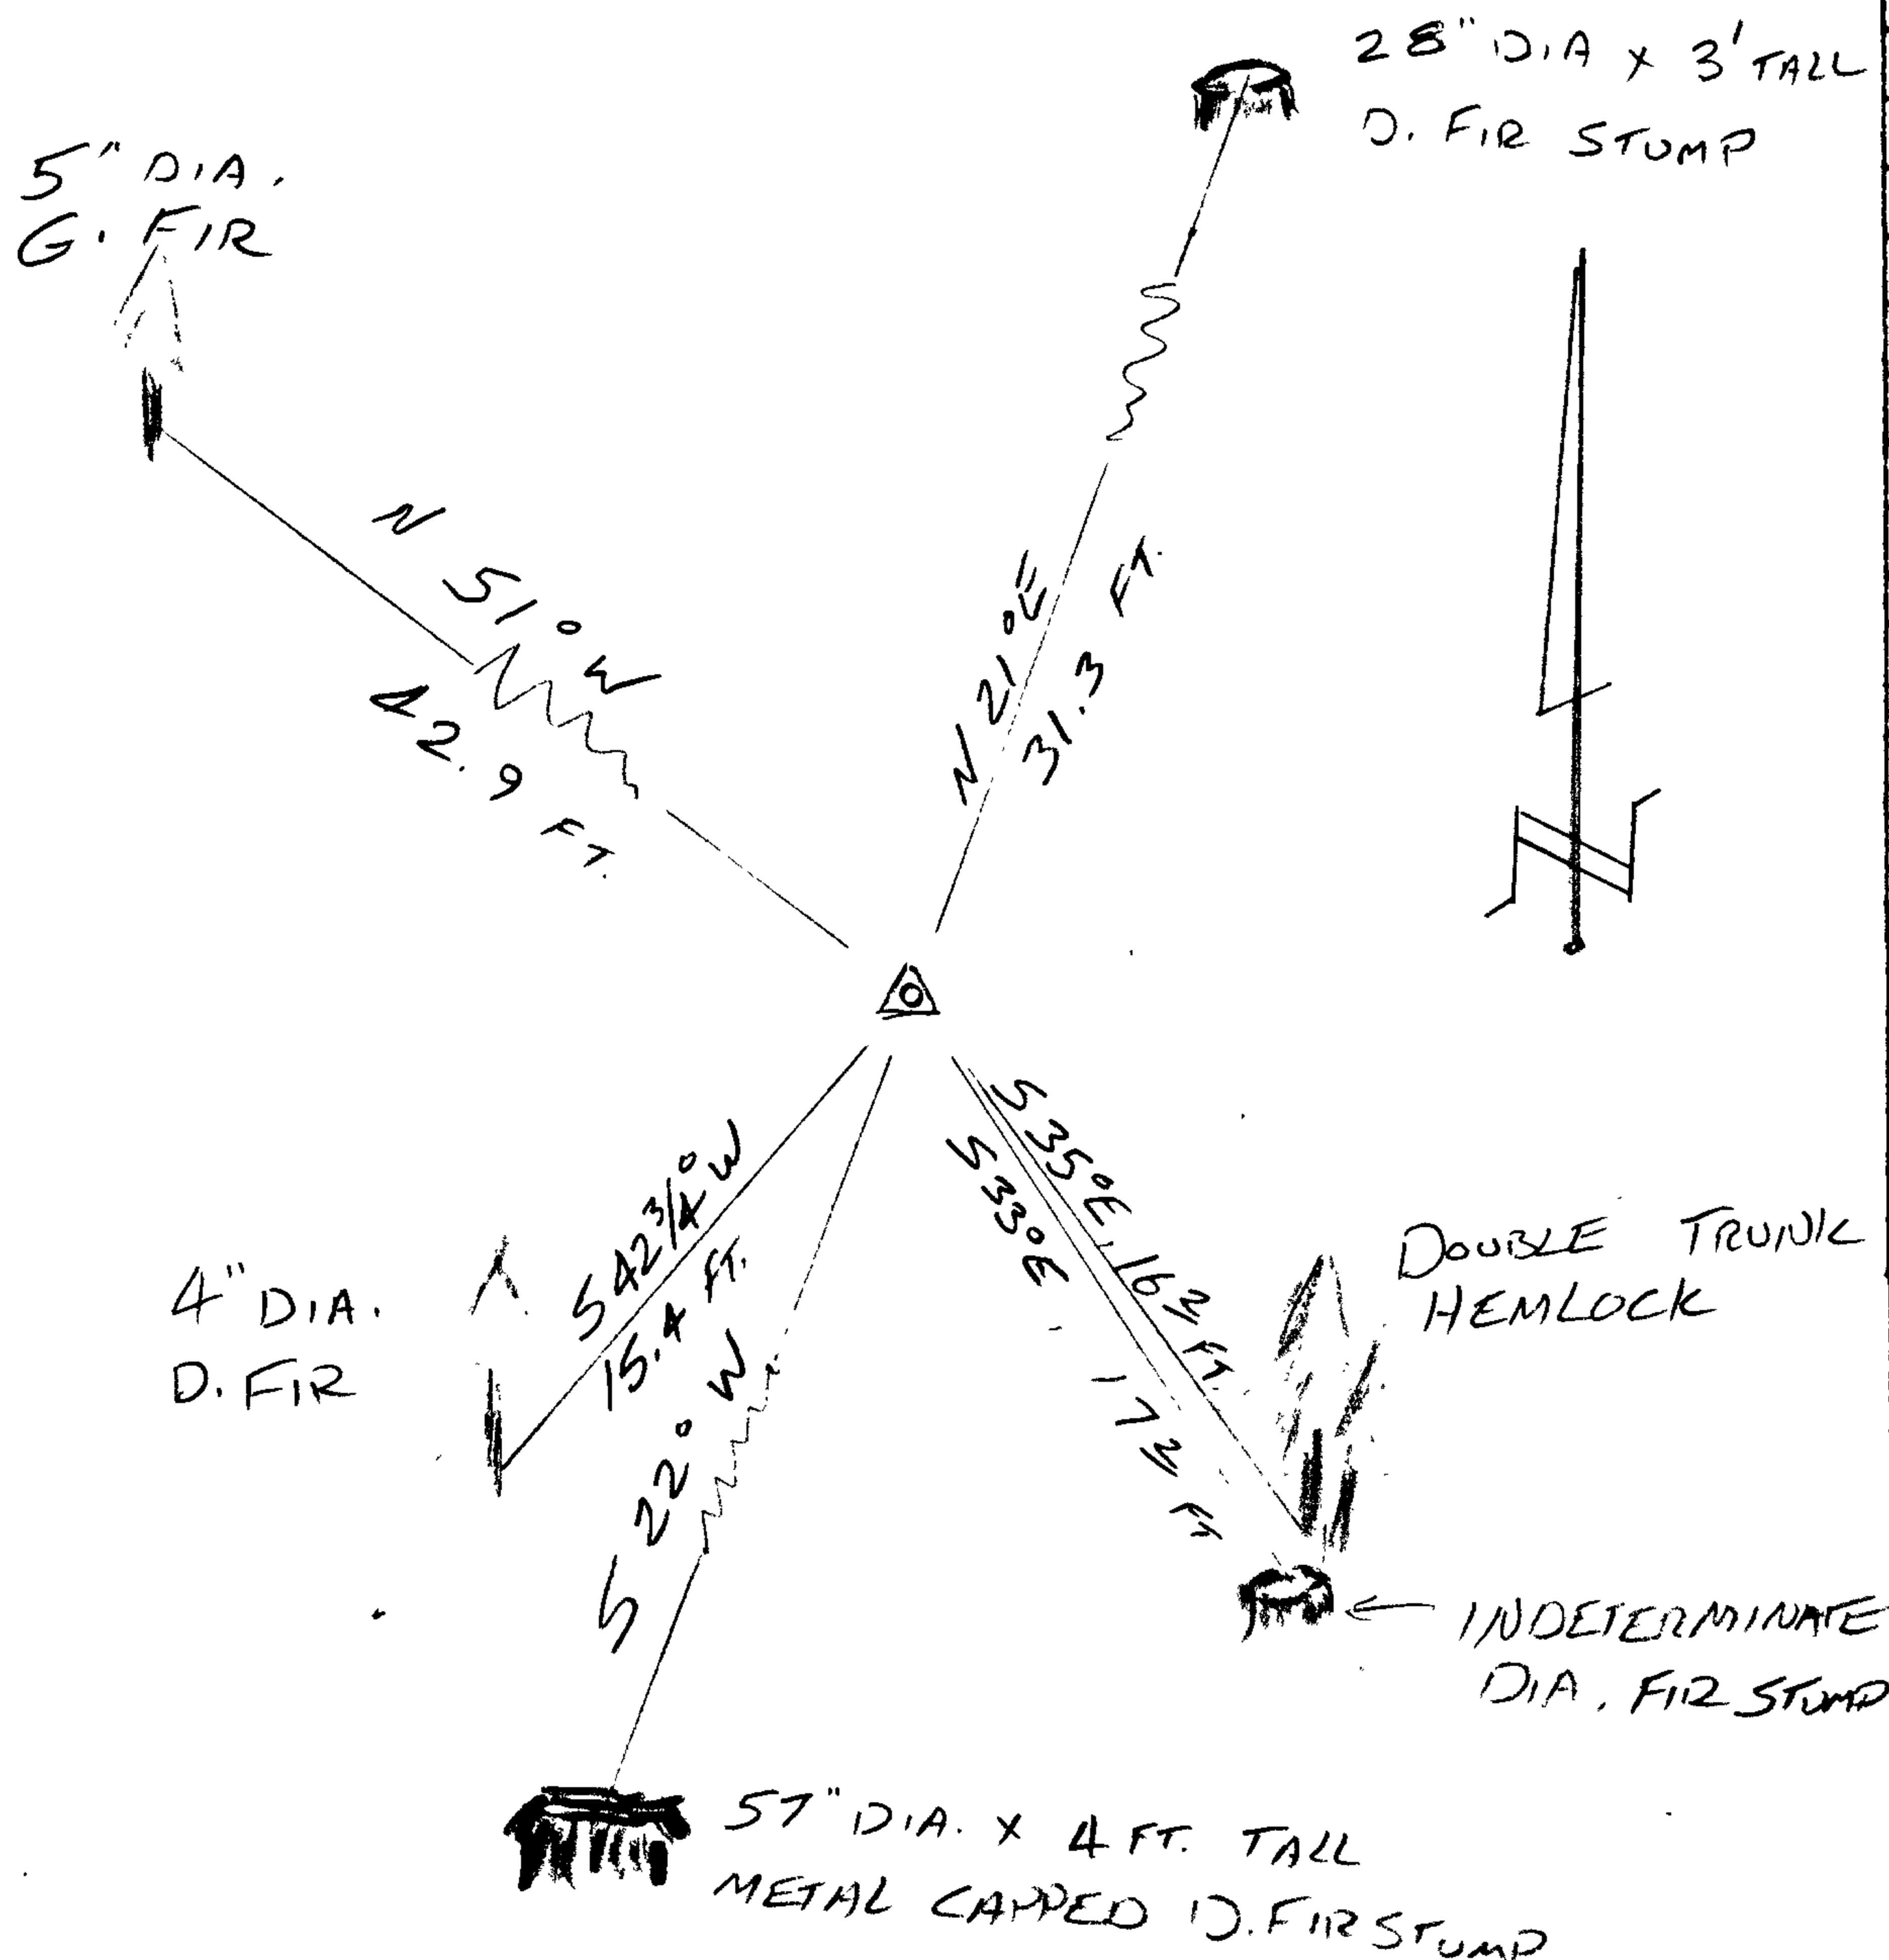

Location & Comments

LIES ON NE FACING SLOPE  
ON WEST SIDE OF STEEP  
DRAW IN DENSE UNDERGROWTH  
AND YOUNG FIR TREES.

Comp. Declin. 16 1/4° E  
Agency P.C.S.O.  
Party Chief S. FLAUSE  
Notekeeper J. PICE  
Witnesses

Address

Surveyor's Seal  
REGISTERED  
PROFESSIONAL  
LAND SURVEYOR

RANDALL W. SMITH  
JULY 25, 1900  
2469