

GOVERNMENT CORNER RESTORATION FORM

FILED

Date: 7/27/07 By: SC

Township 23 S Range SW Sec. 14

County DOUGLAS

This survey consists of:

State OR Date 5/23/2007

No. 500400

Map: _____

Narrative: _____

Corner Rpt: 67/21-42

Corner Designation

SW COR. SEC. 14

DOUGLAS COUNTY

Condition Report Only

Not Found

Renewed

Unrecorded

Surveyed In

Referenced Out


MONUMENT DETAIL

Previous Renewals 1960

Monument(s) Found: (Condition and Source)

2 1/2" DIA. BRASS CAP PROPERLY MARKED ON 1 1/4" O.D. IRON PIPE. FIRMLY SET, PROJECTS 12" ABOVE GROUND.

STONE, TOP MEASURES 6" X 8" FIRMLY SET IS FOUND ON N.E. SIDE OF BC/IP. NO MARKS NOTED ON STONE, DID NOT DIG UP.

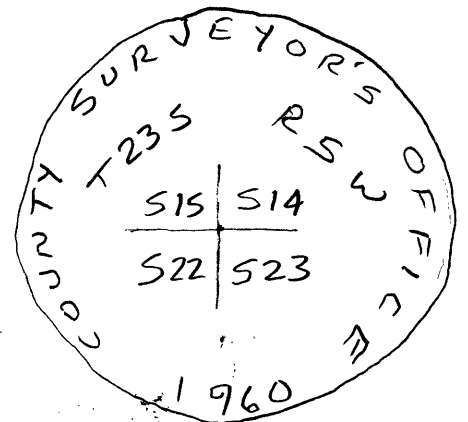

Accessories Found:

12" NOW 19" DIA. B. OAK SNAG, NO MARKINGS VISIBLE ON ROTTING TRUNK. BEARS N 34° W, 84.2 FT. AGREES W/REC. 1960 BT

27" NOW 38" DIA. B. OAK, HEALED SINGLE BLAZE VISIBLE BEARS S 51° W, 82.5 FT. AGREES W/REC. 1960 BT

NO TRACE FOUND OF 1960 NE OR SE BEARING TREES

ORIG 20" DIA. B. OAK NOW 48" DIA X 10 FT TALL ROTTEN SHATTERED STUB. BEARS S 27 3/4° E, 248.8 FT. AGREES W/REC. O.B.T.

C.S. File No 67/21-42

