

GOVERNMENT CORNER RESTORATION FORM

FILED

Date: 7/27/2007 By: JC

This survey consists of:

Township 235 Range SW Sec. 22 County DOUGLAS

State OR Date MAY 23, 2007 No. 500340

Narrative: _____
Corner Rpt: 67/21-43

Corner Designation

$\frac{1}{4}$
S 22 \circ S 23

DOUGLAS COUNTY

SURVEYOR

Condition Report Only

Not Found

Renewed

Unrecorded

Surveyed In


Referenced Out

MONUMENT DETAIL

Previous Renewals 1960

Monument(s) Found: (Condition and Source)

2 1/2" DIA. BRASS CAP PROPERLY MKD.
ON 1 1/4" O.D. IRON PIPE. FIRMLY SET,
PROJECTS 14" ABOVE GROUND.

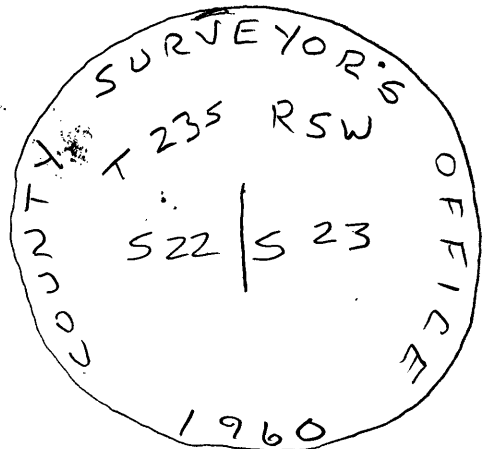

Accessories Found:

16" NOW 27" DIA. W. OAK, HEALED DOUBLE BLAZE
BEARS S 40 1/2° W 56.6 FT. AGREES W/REC 1960 BT

17" NOW 28" DIA. D. FIR, HEALED DOUBLE BLAZE
BEARS S 83° E, 24 3/4 FT. AGREES W/REC 1960 BT

C.S. File No 67/21-43

