

GOVERNMENT CORNER RESTORATION FORM

FILED

Date: 7/27/2007 By: JC

Township 235 Range 5W Sec. 4

County DOUGLAS

This survey consists of:  
Map \_\_\_\_\_

State OR

Date 5/22/2007

No. 037016

Navigation \_\_\_\_\_  
Corner 67/21-46

Corner Designation

NE cor Wilson DLC 37  
NW cor Jeffrey DLC 39


- DOUGLAS COUNTY
- Condition Report Only
  - Not Found
  - Renewed
  - Unrecorded
  - Surveyed In
  - Referenced Out

Previous Renewals

Monument(s) Found: (Condition and Source)

STONE, BURIED APPROX. 12" IN TWO PIECES.  
 MEASURES 20" X 12" X 4" PUT TOGETHER.  
 PIECES FOUND SIDE BY SIDE. STONE IS MARKED  
 "C 37" ON NARROW SIDE "C 39 23S  
 SW" ON WIDE SIDE AND "C 40"  
 ON NARROW SIDE THAT WAS PROBABLY  
 THE TOP. 5/8" IRON ROD IS FOUND  
 ON SOUTH EDGE OF STONE.

MONUMENT DETAIL

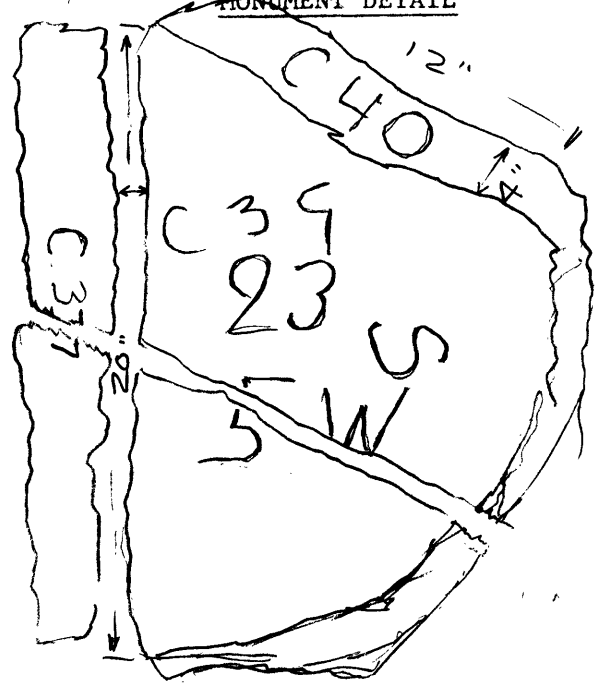

Accessories Found:


C.S. File No 67/21-46

RENEWAL

Monument Detail

Monument Set (Procedure and Description)


2 1/2" DIA. BRASS CAP (MARKED AS SHOWN)  
 ON 1 1/4" O.D. X 30" LONG IRON PIPE  
 24" IN GROUND. MONUMENT WAS SET  
 IN PLACE OF STONE APPROX. 0.25 FT.  
 NORTH OF HAINES 1. ROD. (RECORD STATES  
 1. ROD WAS SET ON SOUTH SIDE OF STONE)  
 STONE WAS PLACED UPRIGHT ON NORTH  
 EDGE OF BC/IP.

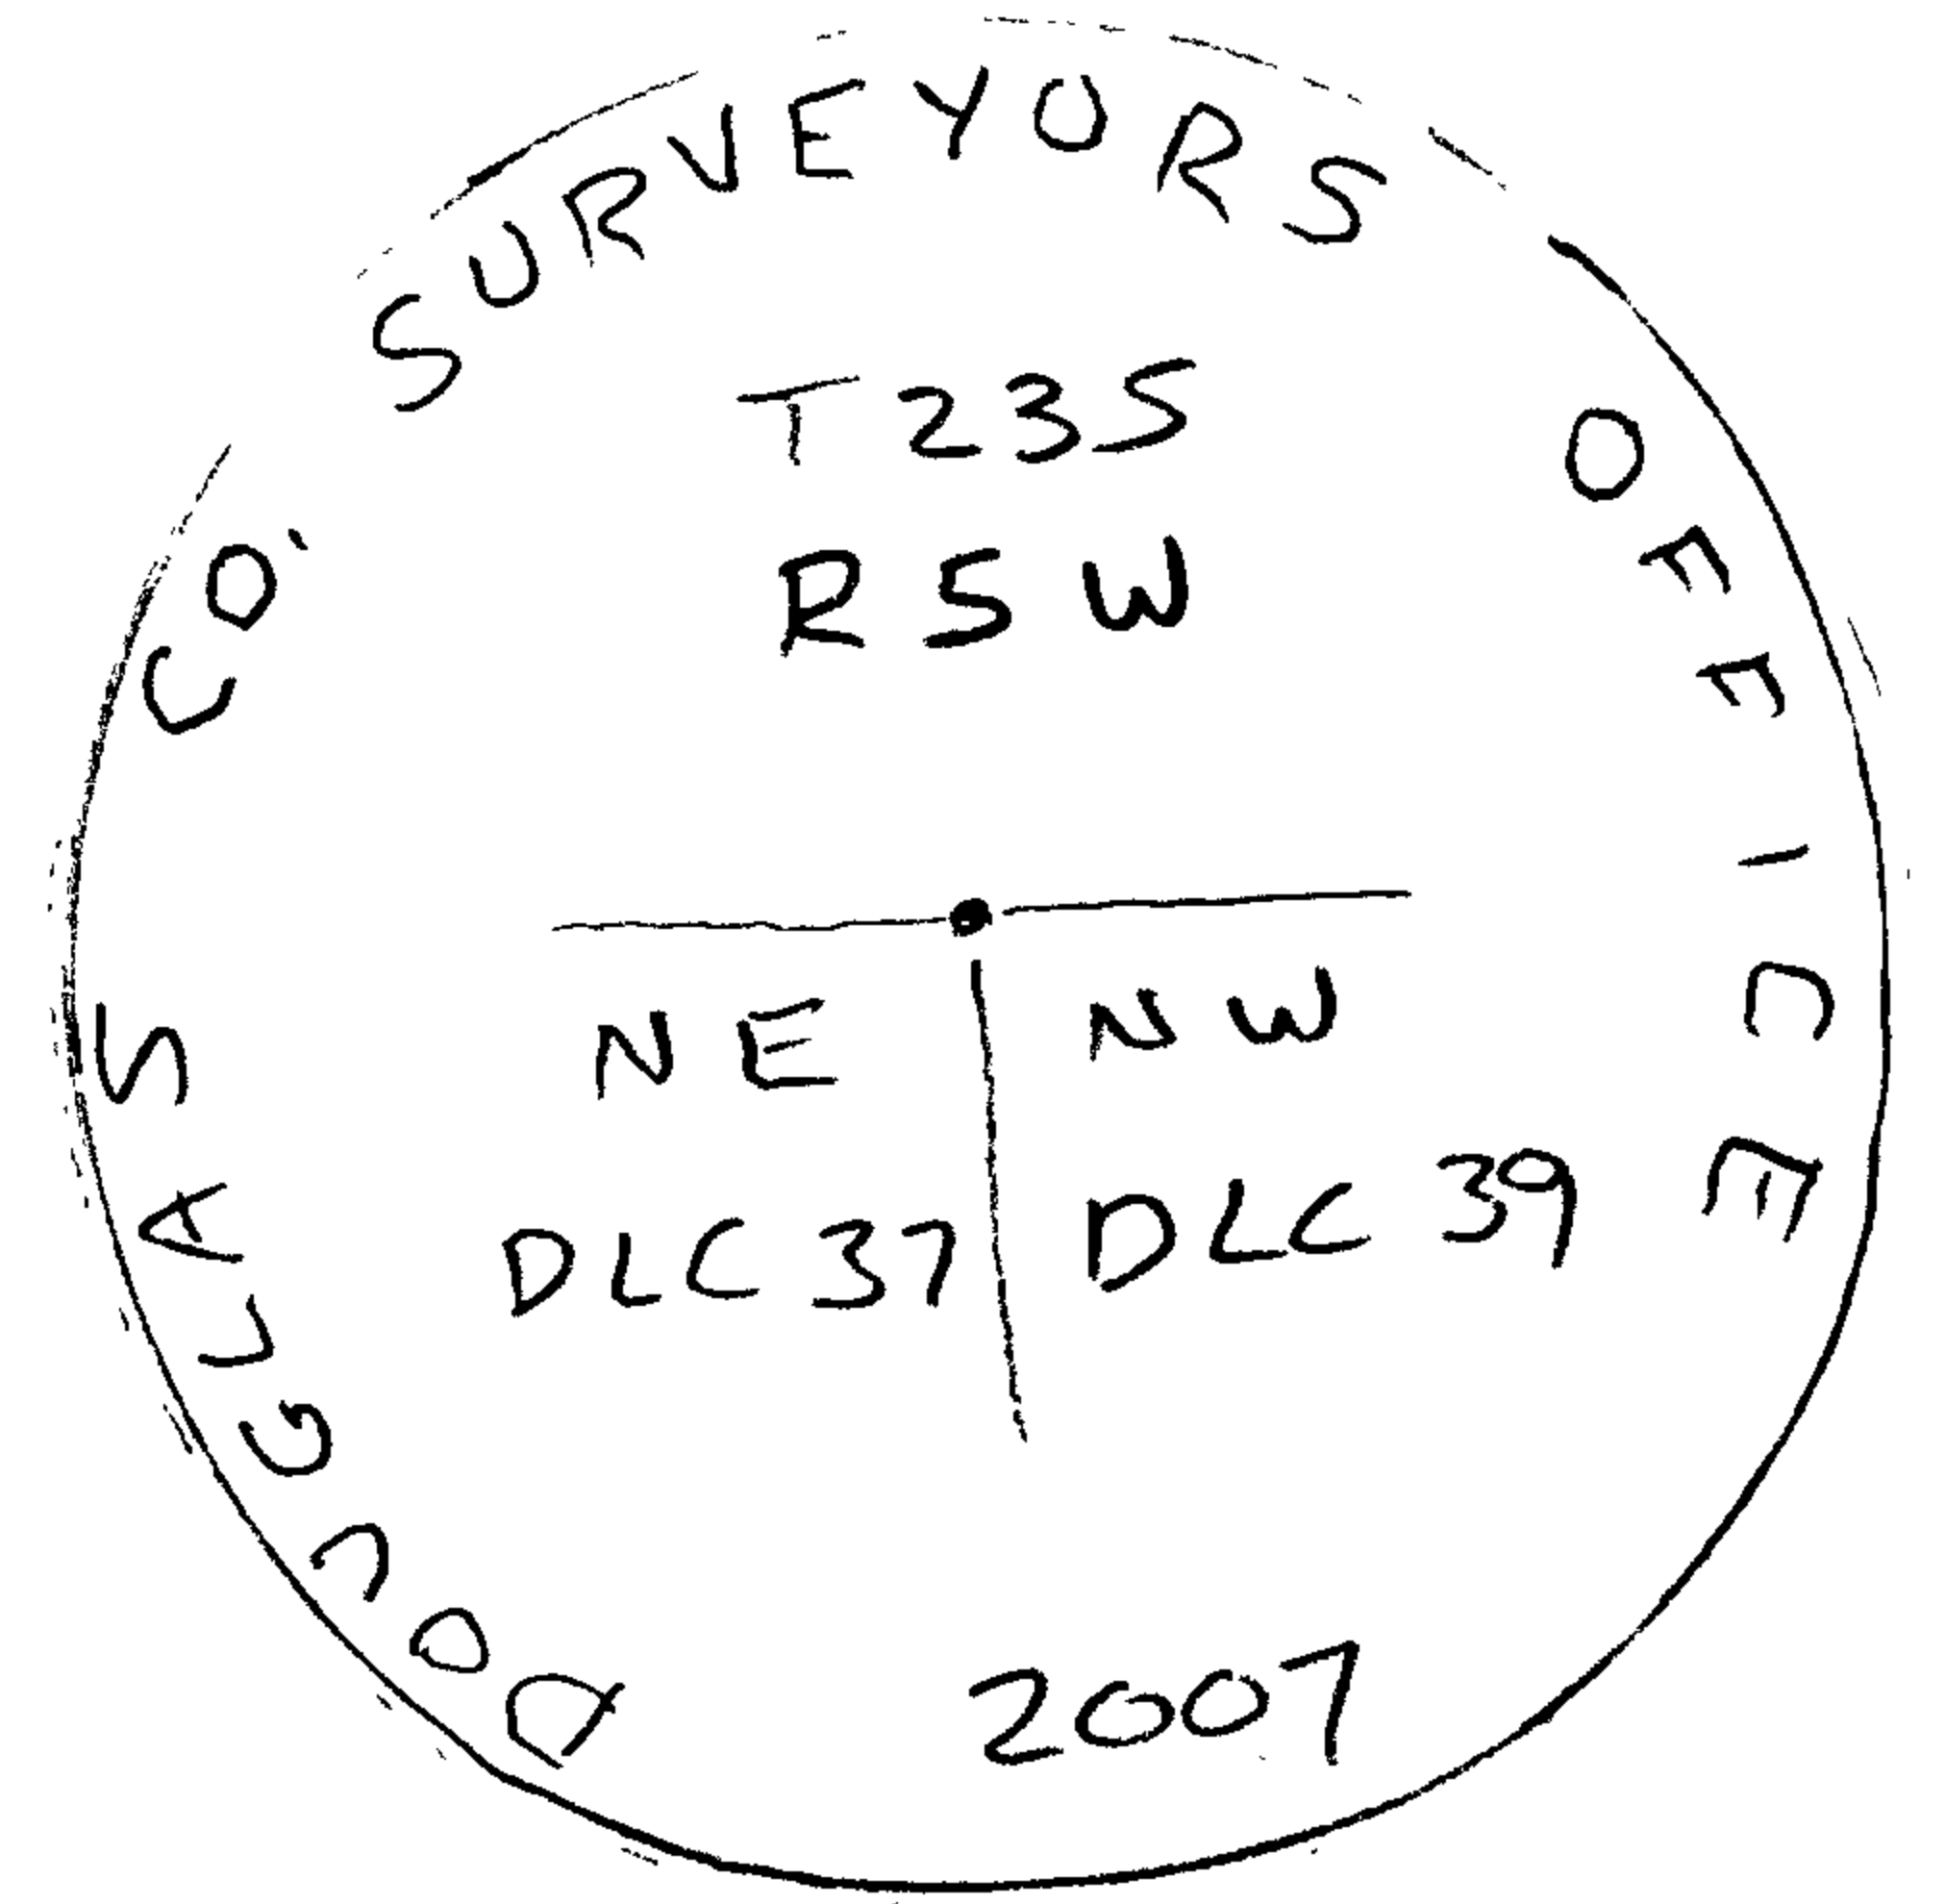

New Accessories

5/8" I. ROD, IN E-W FENCE LINE, TOP LEANS APPROX 0.3 FT WESTERLY  
 PLUMB POSITION BEARS S 89 3/4° E, 99.6 FT. SEE M 92-72  
 DOUBLE TRUNK W. OAK, N. EASTERLY TRUNK IS 17" DIA. AND SCRIBED "NE DLC 37 CSBT"  
 CENTER OF ROOT CROWN BEARS S 19 1/2° W, 42.2 FT.  
 14" DIA APPLE, IN E-W FENCE LINE. TRUNK HOLLOW. SCRIBED "CSBT" ON LOW BLAZE  
 BEARS S 89 1/4° W, 54.1 FT

Sketch of Monument, Accessories, and General Area

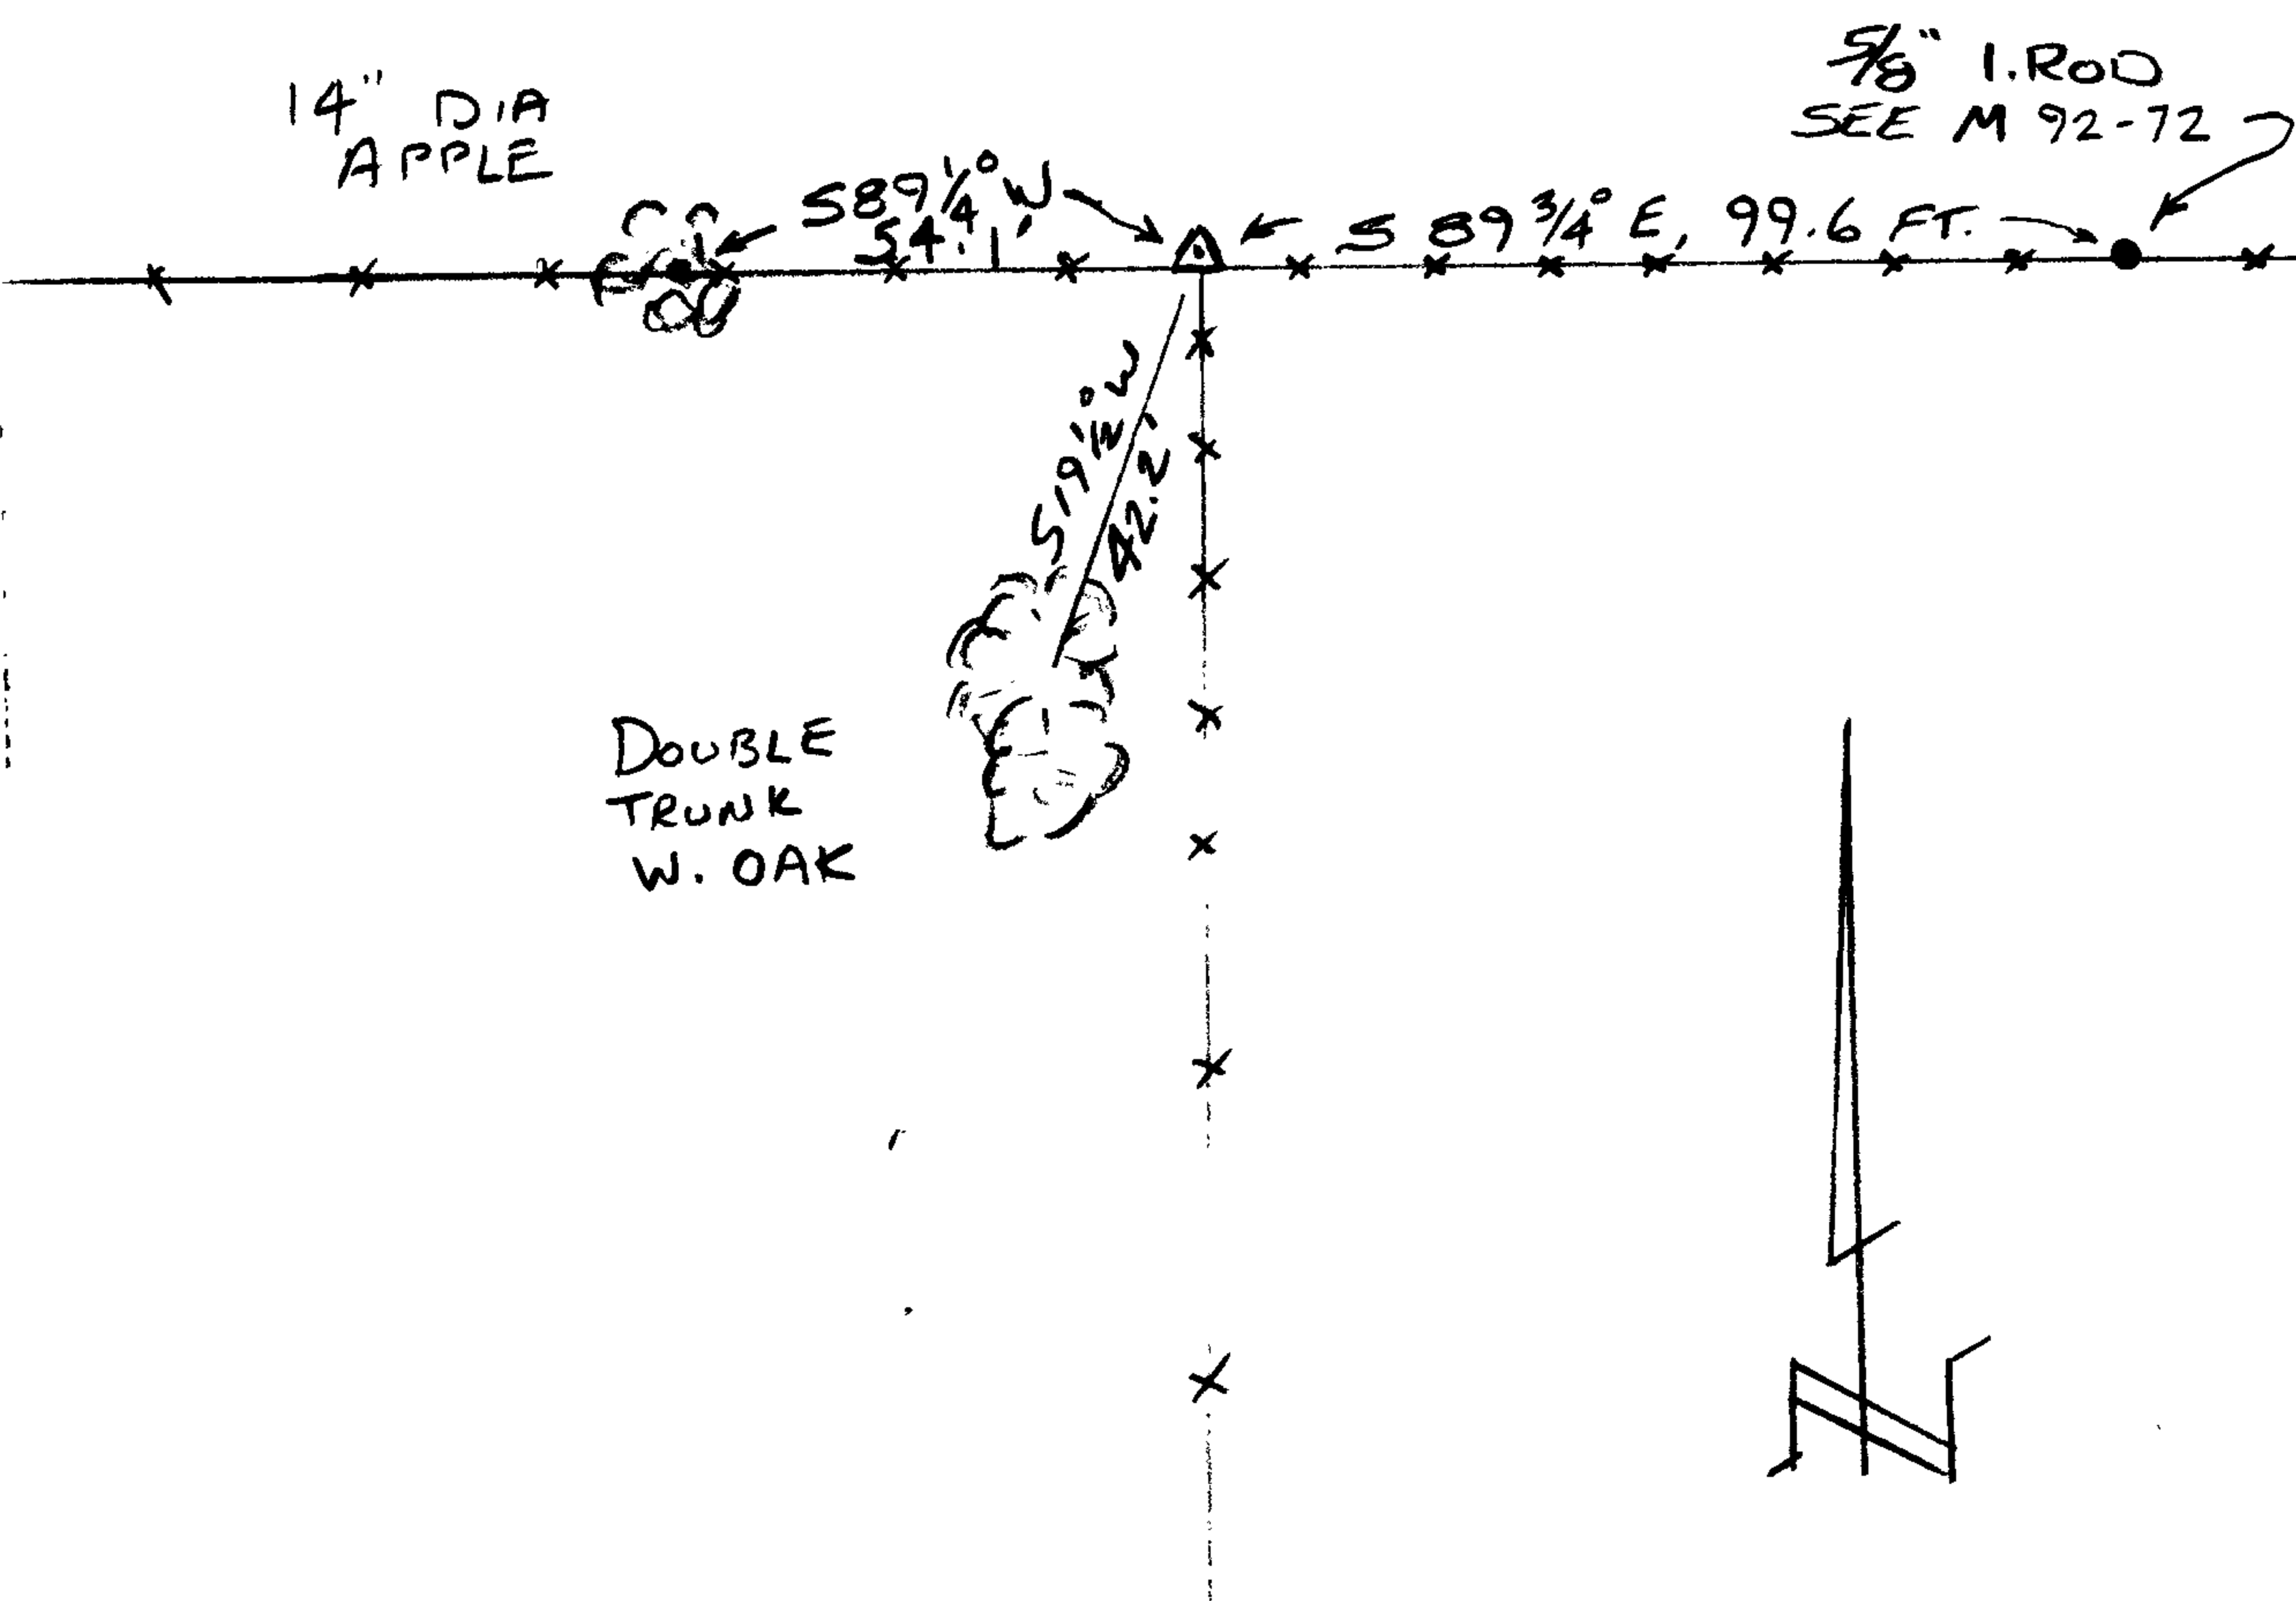


Location & Comments

LIES 0.6 FT. NORTH OF  
 FENCE INTERSECTION WITH  
 FENCES EXTENDING EAST-WEST  
 AND SOUTH. NEAR TOP OF  
 HILL.

Comp. Declin. 16 1/4° E  
 Agency D.C.S.O.  
 Party Chief S. FLAUSE  
 Notekeeper J. PIKE  
 Witnesses \_\_\_\_\_

Address \_\_\_\_\_

Surveyor's Seal

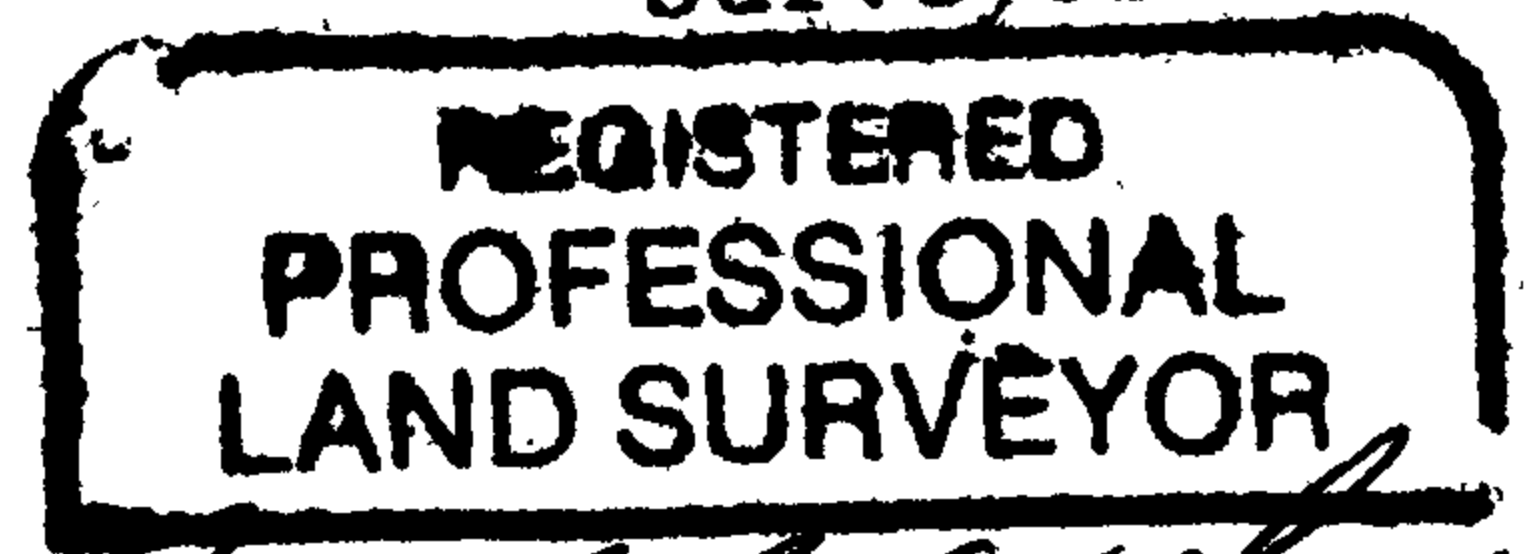

*Randall W. Smith*  
 RENEWAL 6/30/2008

