

GOVERNMENT CORNER RESTORATION FORM

FILED

Township 30S Range 6W Sec. 24 County Douglas Date: 7/27/2007 By: X

State OR Date JULY 9, 2007 No. 04704 Map: \_\_\_\_\_  
This survey consists of:

Corner Designation

SE Cor DLC 47

Narrative: \_\_\_\_\_  
Corner Rpt: 67/21-51


- Original Record Only
- Not Found
- Renewed
- Unrecorded
- Surveyed In
- Referenced Out

Previous Renewals 1947, 1954, 1963

Monument(s) Found: (Condition and Source)

2 1/2" DIA BRASS CAP ON 1 1/4" O.D.  
IRON PIPE PROJECS 14" ABOVE  
GROUND. CENTER OF 4" SOIL PIPE  
BEARS S 60° W 0.25 FT. FROM  
B.C. 3/4" IRON PIPE NOT FOUND  
IN SOIL PIPE

MONUMENT DETAIL

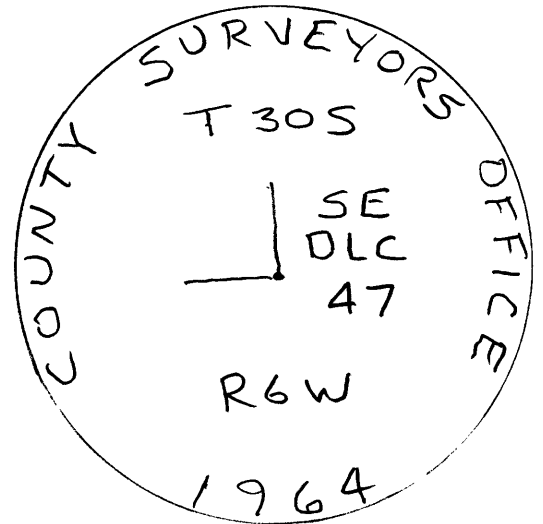

Accessories Found:

ORIG. 18" Now 40" DIA FALLEN W. OAK, CHOPPED OUT  
FACE VISIBLE ROOT HOLE AGREES WELL W/REC. O.B.T.

ORIG. 15" Now 35" DIA. W. OAK, WELL HEALED SCAR. APPEARS  
TO HAVE BEEN OPENED, BEARS N 45° E 43.5 FT  
AGREES W/REC O.B.T.

C.S. File No 67/21-51

