

GOVERNMENT CORNER RESTORATION FORM

Date: 7/27/2007 By: Jc

This survey consists of:

Township 305 Range 6W Sec. 13 County DOUGLAS Map: _____

State OR Date 7/9/07 No. 047010 Narrative: _____

Corner Rpt: 67/21-52

Corner Designation

NE COR DLC 47

DOUGLAS COUNTY
SURVEYOR


- Condition Report Only
- Not Found
- Renewed
- Unrecorded
- Surveyed In
- Referenced Out

Previous Renewals 1954, 1978

MONUMENT DETAIL

Monument(s) Found: (Condition and Source)

- 2 1/2" DIA. BRASS CAP, FLUSH WITH GROUND, MKD. AS SHOWN.
 - 3/4" I.D. IRON PIPE IS FOUND ON WEST EDGE OF B.C. A STEEL FENCEPOST IS ALSO FOUND ALONG SIDE BC/IP.
STONE WAS NOT DUG UP OR SEARCHED FOR.

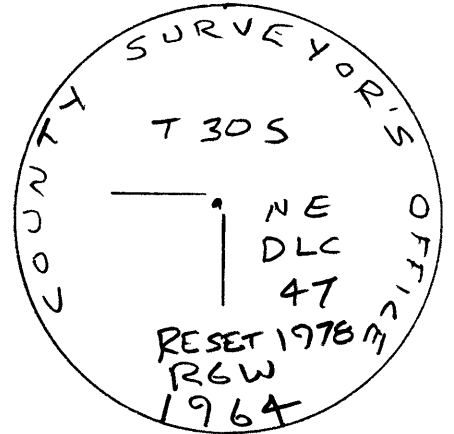

Accessories Found:

- SOUTH-SOUTH EAST CORNER OF HOUSE BEARS N 38°W, 33.6 FT AGREES W/REC. 1978
- POWER POLE # C 8077 HAS BEEN REPLACED (SEE NEW ACCESSORIES FOR NEW INFORMATION)

