

GOVERNMENT CORNER RESTORATION FORM

FILED

Township 28 S Range 4 W Sec. 13

County Douglas

Date: 7/27/2007 P.V. X

State OR

Date 7-17-2007

No. 640400

This survey consists of:

Corner Designation

SOUTH $\frac{1}{4}$ COR SEC. 13

Corner Ept: 67/21-53


- Condition Report Only
- Not Final
- Renewed
- Unrecorded
- Surveyed In
- Referenced Out

Previous Renewals 1957, 1965

Monument(s) Found: (Condition and Source)

2 1/2" DIA. BRASS CAP ON
1 1/4" O.D. IRON PIPE, MKD. AS
STANDARD PROJECTS 11" ABOVE GROUND
FIRMLY SET.
A 1 1/4" X 7 1/2" IRON BAR IS FOUND
ON NORTH SIDE OF BCLIP

MONUMENT DETAIL

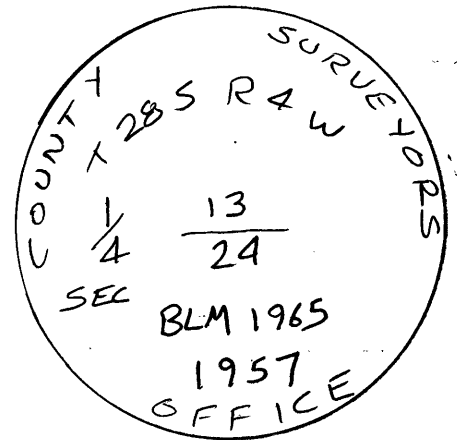

Accessories Found:

ORIG. 30" DOUBLE FIR NOW 48" DIA, ALIVE, LEANS WESTERLY,
ON BARK, BEARS S 6° W, 44.2 FT. TO CENTER
OF ROOT CROWN (RECORD HAS CHANGED ON EACH VISIT) O.B.T.

24" W. FIR NOW 26" DIA, ROTTED CAPPED STUMP 4 FT. TALL
NO VISIBLE MARKS BEARS N 61° E 17.2 FT.
AGREES w/REC. 1957 BT

