

FILED

GOVERNMENT CORNER RESTORATION FORM

Date: 8-1-07 By: JC

This survey consists of:

Township 24S Range 5W Sec. 6

County DOUGLAS Map: _____

State OR Date 7-11-07

No. 140700

Narrative: _____
Corner Rpt: 67/24-1

Corner Designation

N 1/4 SEC. 6

**DOUGLAS COUNTY
SURVEYOR**


- Condition Report Only
- Not Found
- Renewed
- Unrecorded
- Surveyed In
- Referenced Out

MONUMENT DETAIL

Previous Renewals _____

Monument(s) Found: (Condition and Source)

2 1/2" DIA. BRASS CAP ON 1 1/4" O.D. IRON PIPE, FIRMLY SET, MKD. AS SHOWN PROJECTS 8" ABOVE GROUND NOTED EXTRA LINE BETWEEN S AND 31 ON B.C. STAMPING.

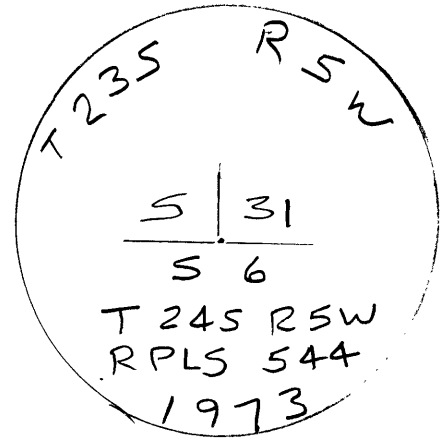

Accessories Found:

8" NOW 17" DIA. D. FIR FULLY HEALED SINGLE BLAZE BEARS N 26° W, 15.4 FT. (AGREES W/REC.) 1973 BT

16" NOW 6 FT. TALL X 17" ROTTED D. FIR STUMP PARTIALLY HEALED SINGLE BLAZE BEARS S 20° E, 40.7 FT. (AGREES W/REC) 1973 BT

C.S. File No 67/24-1

