

FILED SEP 26 2007

AUG. 21, 2007

T 24 S R S W 440 500

$\frac{1}{4}$ COR $\frac{10}{15}$

FD. AS PER RECORD

D. C. S. O.

J. PIKE


S. FLAUSE

K. INDA

C 082112A



[Handwritten signature]

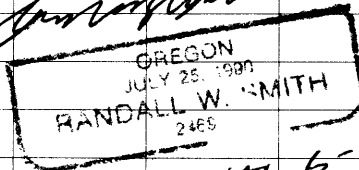

RENEWAL 6-30-08

C

C.S. File No 67/24-9