

GOVERNMENT CORNER RESTORATION FORM

FILED

Date: 9/26/07 By: X

Township 24S Range 5W Sec. 1

County DOUGLAS This survey consists of:

State OR Date AUG. 30, 2007

No. 700640 Map: _____

Corner Designation

$\frac{1}{4}$
SEC. 1 * SEC. 6

Narrative: _____
Corner Rpt: 67/24-16


DOUGLAS COUNTY
SURVEYOR
 Condition Report Only
 Not Found
 Renewed
 Unrecorded
 Surveyed In
 Referenced Out

Previous Renewals 1960

MONUMENT DETAIL

Monument(s) Found: (Condition and Source)

2 1/2" DIA. BRASS CAP, PROPERLY
MARKED PROJECTS 12" ABOVE
GROUND, FIRMLY SET.

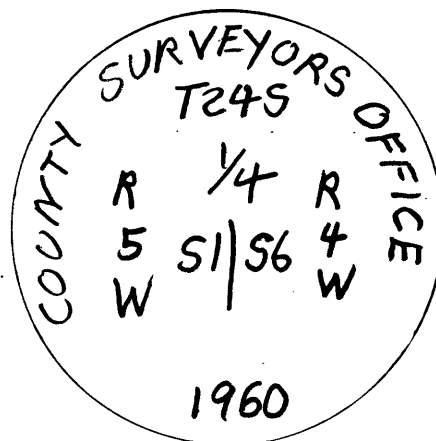

Accessories Found:

- 8" NOW 26" DIA. X 1 1/2 FT. TALL FIR STUMP, HEALED
LOWER BLAZE VISIBLE, BEARS S 32 1/2° E, 9.9 FT.
(AGREES W/REC) 1960 BT
- 12" NOW 16" DIA. W. OAK, FULLY HEALED DOUBLE BLAZE
BEARS S 23° W, 23.7 FT. (REC. S 26° W, 23.7 FT.) 1960 BT
- ORIG 12" DIA. B. OAK NOW 28" DIA. FALLEN SNAG ARE MARKS
VISIBLE, ROOT HOLE AGREES WELL W/ 1960 REC. (S 11° W, 158.4 FT.)
O.B.T.
- ORIG 14" DIA. B. OAK NOW 32" DIA. SNAG BEARS S 67° E, 95.0 FT
TO FACE. (1960 REC S 67° E, 95.0 FT.) O.B.T.

C.S. File No 67/24-16

