

FILED OCT 16 2007

G.S. - C101010A

OCT. 10, 2007

T. 25-6-054030

SW COR DLC 53

FOUND 3/4" x 2" IRON BAR IN  
N-S FENCELINE, NOTED  
4 LIVE BEARING TREES AS  
PER RECORD

T. 25-6-038010

N. NE COR. DLC 38

FOUND BRASS CAP WITNESS  
CORNER. 32" B. OAK NOTED 8/2000  
NOW BARELY ALIVE. W. OAK BT  
HEALTHY. GUY WIRE INTACT.  
CORNER LIES IN BLACKBERRY  
BRAMBLE PATCH. IS STABLE.

T. 25-6-040010

NE COR DLC 40

FOUND: 1/2" IP BENT OVER  
2" BELOW GROUND. REFERENCED  
PLUMB POSITION, REMOVED, STRAIGHTENED  
AND SET BACK IN REFERENCED POSITION  
2" BELOW GROUND. (OVER)

C.S. File No 67/24-23

10" W. OAK, N 65 1/2° W, 8.2 FT.  
NOW REMOVED. ALL OTHER  
ACCESSORIES FROM 2002 RENEWAL  
INTACT.

T. 25-6-100340


FOUND: CORNER TREE W/ ALUM  
NAIL IN N. FACE OF TREE;  
3/4" DIA. BRASS CAP R.M.

13" W. OAK, N 32° W, 12.5 FT


8" W. OAK, N 87° E, 36.0 FT.

ALL OTHER B.T.'S NOW  
DOWN.

D.C.S.O.  
J. PIKE  
S. FLAUSE

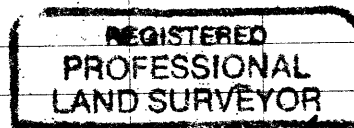

*Randall W. Smith*

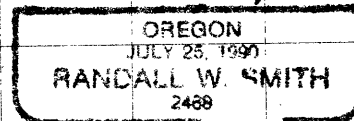

RENEWAL  
6-30-09