

GOVERNMENT CORNER RESTORATION FORM

Date: 10-16-2007 By: JC

Township 25S Range 4W Sec. 36 County Douglas

This survey consists of:

State OR Date 9-26-07 No. 700140 Narrative:

Corner Rpt: 67/24-27

Corner Designation

EAST 1/4 COR SEC. 36

DOUGLAS COUNTY SURVEYOR

Condition Report Only

Not Found

Renewed

Unrecorded

Surveyed In


Referenced Out

Previous Renewals 1903, 1943

MONUMENT DETAIL

Monument(s) Found: (Condition and Source)

FOUND 2 1/2" DIA. BRASS CAP MARKED AS PER REC ON 1" O.D. IRON PIPE, PROJECTS 22" ABOVE GROUND. BASE OF IRON PIPE APPEARS UNDISTURBED

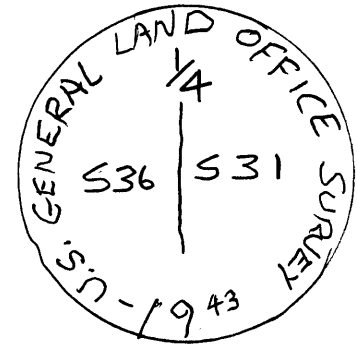

Accessories Found:

30" NOW 25" DIA. BURNT FIR SNAG, APPROX 50 FT. TALL, TAGGED NO MARKS VISIBLE BEARS S 70° E, 6.6 FT. TO CENTER OF ROOT CROWN, 1943 REC! DIST. WOULD FIT WELL AS A FACE MEAS. (1943 REC. S 70° E, 4.6 FT.) O.B.T

22" FIR NOW BLOW DOWN, IS TAGGED, - NO POSITION; ROOT HOLE IN DETERMINATE (REC. N 42 1/2° W, 29.7 FT) 1943 BT

NO TRACE OF ANY OTHER BT'S NOTED

