

GOVERNMENT CORNER RESTORATION FORM

Date: 10/16/2007 By: JC

Township 26S Range 3W Sec. 6 County DOUGLAS

This survey consists of:

State OR Date 10-8-2007 No. 20070

Corner Rpt: 67/24-29

Corner Designation

NE COR SEC 6

DOUGLAS COUNTY
SURVEYOR

Condition Report Only


Not Found

Renewed

Unrecorded

Surveyed In

Referenced Out

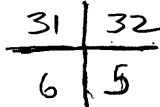


Previous Renewals 1943, 1966

MONUMENT DETAIL

Monument(s) Found: (Condition and Source)

2 1/2" DIA BRASS CAP, PROPERLY MARKED, ON 2" O.D. IRON PIPE BC/IP LEANS SOUTHERLY 0.9 FT AS IT IS BEING FORCED TO BE ON SOUTH SIDE OF E-W FENCE THERE IS ALSO A WIRE WRAPPED AROUND BC/IP TO TENSION A SOUTH FENCE LINE EMANATING FROM THIS CORNER. BC/IP PROJECTS 10" ABOVE GROUND.

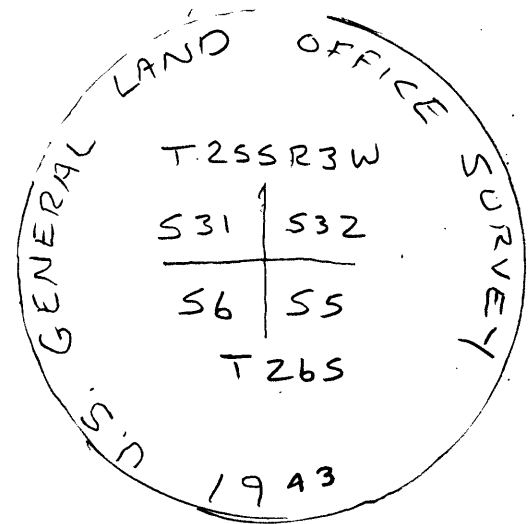

Accessories Found:

- 7" NOW 28" DIA. D. FIR, FAINT LOW BLAZE VISIBLE BEARS N 19 1/4° E 49.4 MEAS. 50.2 ON SLOPE (REC. N 23 1/2° E, 50.2 FT.) 1943 BT 1966
- 60" FIR STUMP NOW INDETERMINATE DIA. X 5 FT. TALL ROTTED D.FIR STUMP, PARTIAL SCRIBING VISIBLE ON ROTTING BLAZE BEARS N 12 3/4° E, 42.9 FT. (AGREES W/REC) 1943 BT
- 40" FIR STUMP NOW INDETERMINATE DIA. SHATTERED 8 FT. TALL ROTTING STUMP NO MARKINGS VISIBLE, BEARS S 60° W, 4.6 FT. (AGREES W/1943 & 1966 RECORDS) O.B.T.

