

GOVERNMENT CORNER RESTORATION FORM

FILED

Date: 10/19/2007 By: X

Township 29S Range 5W Sec. 16

County DOUGLAS This survey consists of:

State OR

Date 10-15-07

No. 300408

Map: _____

Narrative: _____

Corner Designation

Corner Rpt: 67/24-32

| | |
|----|----|
| 17 | 16 |
| 20 | 21 |

DOUGLAS COUNTY
Condition Report Only
SURVEYOR

Not Found

Renewed

Unrecorded

Surveyed In


Referenced Out

Previous Renewals 1921, 1962

MONUMENT DETAIL

Monument(s) Found: (Condition and Source)

1/2" I.D. IRON PIPE, PROJECTS
10" ABOVE GROUND PIPE
IS WIRED ONTO RAILROAD
TIE FENCE POST

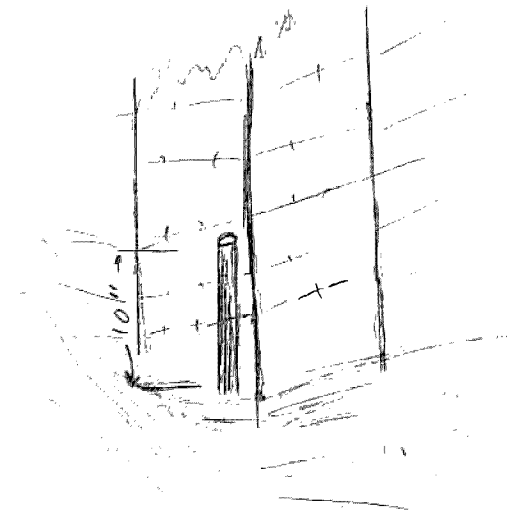

Accessories Found:

CHISELED 'X' ON 12" X 16" X 14" TALL STONE, 'X' IS
3" TALL AND IS NEAR SOUTH END OF TOP OF STONE.
BEARS N24° E 23.6 FT. HORIZ. MEASURES 24.0 ON SLOPE
(REC. N 24° E, 24.0 FT.) 1962 ACC.

30" NOW 27" DIA. PINE WITH BROKEN OFF TOP AND POWER
LINES ATTACHED, PREVIOUSLY GIVEED BURNT BLAZES
WITH NO MARKS VISIBLE BEARS S 3 1/2° W, 100.0 FT
(AGREES W/REC) 1921 13T

