

GOVERNMENT CORNER RESTORATION FORM

FILED

Date: 11-5-2007 By: JC

Township 26 S Range 6 W Sec. 13

County DOUGLAS This survey consists of:

State OR Date APR. 5, 2007

Map: _____
Narrative: _____

Corner Designation

Corner Rpt: 67/24-33

SSW CORNER CLINKENBEARD
DLC 52

- DOUGLAS COUNTY
SURVEYOR
- Condition Report Only
 - Not Found
 - Renewed
 - Unrecorded
 - Surveyed In
 - Referenced Out

Previous Renewals _____


MONUMENT DETAIL

Monument(s) Found: (Condition and Source)

2 1/2" DIA BRASS CAP, PROPERLY
MARKED, PROJECTS 2" ABOVE
GROUND.

DID NOT DIG UP SANDSTONE AS
NOTED ON DeGROOT'S MAP.

NOTE: AS OF TODAY NOV. 1, 2007
DeGROOTS MAP STILL NOT FILED

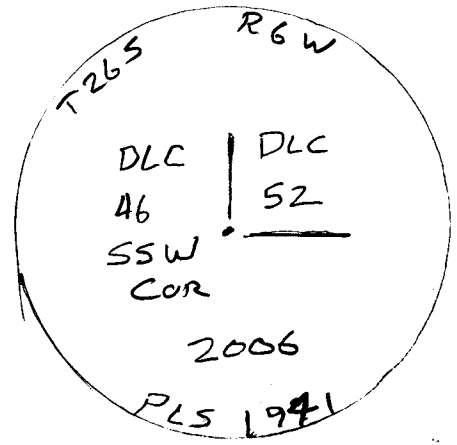

Accessories Found:

NO ACCESSORIES NOTED ON DeGROOTS MAP

