

GOVERNMENT CORNER RESTORATION FORM

Date: 11/5/2007 By: JC

Township 265 Range 3W Sec. 7

County DOUGLAS

This survey consists of:

State OR

Date 10/23/07

No. 100540

Narrative:

Corner Rpt: 67/24-34

Corner Designation

WEST 1/4 COR SEC. 7

DOUGLAS COUNTY SURVEYOR

- Condition Report Only
- Not Found
- Renewed
- Unrecorded
- Surveyed In
- Referenced Out


MONUMENT DETAIL

Previous Renewals: 1921, 1966

Monument(s) Found: (Condition and Source)

2 1/2" DIA BRASS CAP PROPERLY MARKED ON 1 1/4" O.D. IRON PIPE PROJECTS 12" ABOVE GROUND

1" I.D. IRON PIPE BEARS APPROX N 45° E, 0.7 FT.

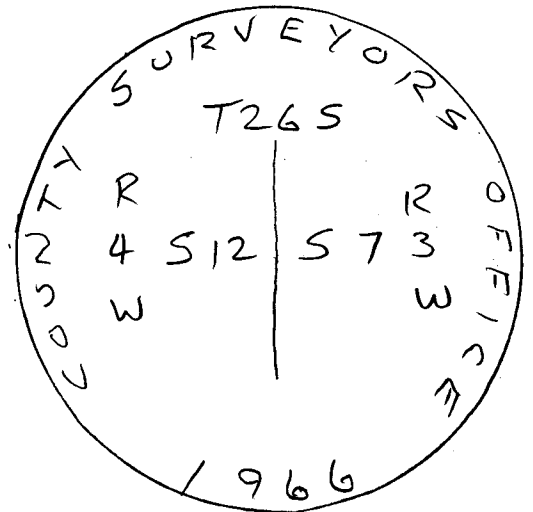

Accessories Found:

14" Now 23" DIA. W. OAK, FULLY HEALED DOUBLE BLAZE, BEARS N 56° W, 144.0 FT. (REC N 56° W, 145.8 FT) REC. DIST. FITS WELL AS SLOPE MEASUREMENT

- NO TRACE OF ANY OTHER ACCESSORIES FOUND

