

GOVERNMENT CORNER RESTORATION FORM

Date: 11-5-2007 By: JC

Township 25S Range 6W Sec. 6

County DOUGLAS This survey consists of:

State OR Date 10/24/07

No. 100600 Narrative: \_\_\_\_\_

Corner Rpt: 67/24-35

Corner Designation

SW COR SEC 6

DOUGLAS COUNTY

Condition of Report Only

Not Found

Renewed

Unrecorded

Surveyed In


Referenced Out

Previous Renewals 1896, 1963

Monument(s) Found: (Condition and Source)

2 1/2" DIA BRASS CAP, PROPERLY MARKED ON 1 1/4" O.D. IRON PIPE. PROJECTS 12" ABOVE GROUND, FIRMLY SET. STEEL FENCE POST FOUND TO NE APPROX 6" AWAY.

MONUMENT DETAIL

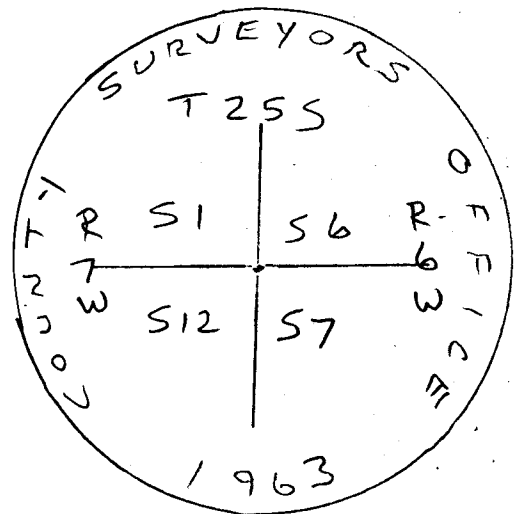

Accessories Found:

- 38" Now 37" DIA X 9 FT TALL D. FIR STUMP, PARTIAL BARK SCRIBE '6' VISIBLE, BEARS S 2° W, 13.4 FT., 11.9 FT TO FACE. (1963 REC. S 2° W, 11.9 FT. TO FACE OF TREE) O.B.T.
- 36" Now 36" DIA X 8 FT TALL D. FIR STUMP, ROTTED BLAZE, BEARS S 5° E 19.0 FT NOTE: STUMP IS PISTOL BUTT. (AGREES W/REC.) O.B.T.
- 24" Now 24" <sup>DIA</sup> X 10 FT TALL BROKEN OFF D. FIR STUMP, PARTIALLY HEALED BLAZE ~~STUMP~~ ILLEGIBLE SCRIBE, BEARS N 55° E, 4.2 FT. (AGREES W/1963 REC) OBT
- 24" Now 24" <sup>DIA</sup> X 6 FT TALL <sup>D. FIR</sup> STUMP, BURNT FACE W/BURLING VISIBLE BEARS N 38° W, 4.5 FT. (AGREES W/1963 REC) OBT
- 16" Now 12" DIA X 8 FT TALL D. FIR STUMP, FACE BURNT OFF, BEARS S 22° W, 21.8 FT (AGREES W/REC.) 1963 BT

