

GOVERNMENT CORNER RESTORATION FORM

Date: 11-5-2007 By: JC

This survey consists of:

Township 26S Range 3W Sec. 7

County DOUGLAS

State OR

Date OCT. 25, 2007

No. 140560

Corner Rpt: 67/24-36

Corner Designation

SOUTH 1/4 SEC 7

DOUGLAS COUNTY SURVEYOR

Condition Report Only

Not Found

Renewed

Unrecorded

Surveyed In


Referenced Out

MONUMENT DETAIL

Previous Renewals 1955, 1966

Monument(s) Found: (Condition and Source)

2 1/2" DIA. D.C.S.O. BRASS
CAP ON 1 1/4" O.D. IRON PIPE
PROPERLY MARKED; PROJECTS
9" ABOVE GROUND. FIRMLY SET.

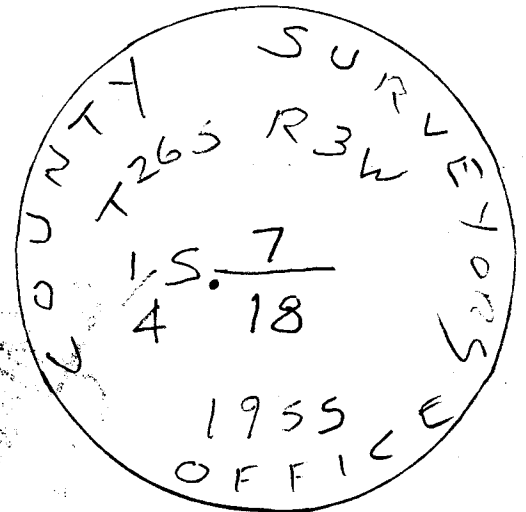

Accessories Found:

NO SIGN OF ANY PREVIOUS ACCESSORIES OR
ROOT HOLES DETECTED. 30 FT. CALL TO SEASONAL
CREEK FITS REASONABLY WELL.

