

FILED

GOVERNMENT CORNER RESTORATION FORM

Date: 12/4/2007 By: JC

Township 26 S Range 3 W Sec. 4

County Douglas This survey consists of:

State OR

Date 10/30/07
11/5/07

No. 30069 Narrative: _____

Corner Rpt: CS 67/24-42

Corner Designation

SW COR SEC 4

DOUGLAS COUNTY


- Condition Only
- Not Found
- Renewed
- Unrecorded
- Surveyed In
- Referenced Out

MONUMENT DETAIL

Previous Renewals 1924, 1966

Monument(s) Found: (Condition and Source)

2 1/2" DIA BRASS CAP ON
A 2" O.D. IRON PIPE PROPERLY
MARKED. PROJECTS 9" ABOVE
GROUND.

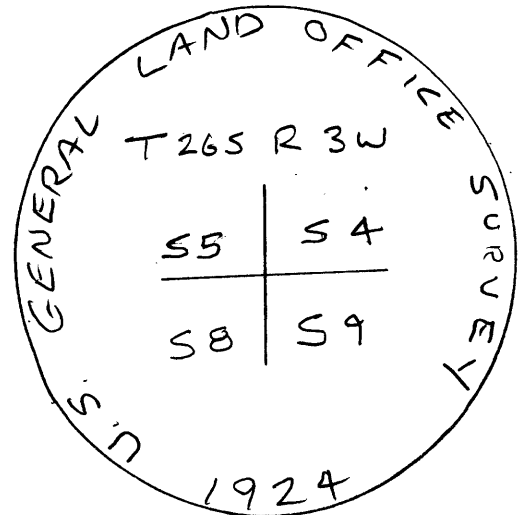

Accessories Found:

16" Now 20" DIA. X 2 FT. TALL ROTTED FIR
STUMP LIES IN REMNANTS OF OLD E-W FENCE
SCRIBING "SR 3 W" VISIBLE ON ROTTEN BLAZE BEARS
N 39° E, 5.3 FT. (AGREES W/REC) 1924 BT

NO SIGN OF ANY OTHER ACCESSORIES FOUND

C.S. File No 67/24-42

